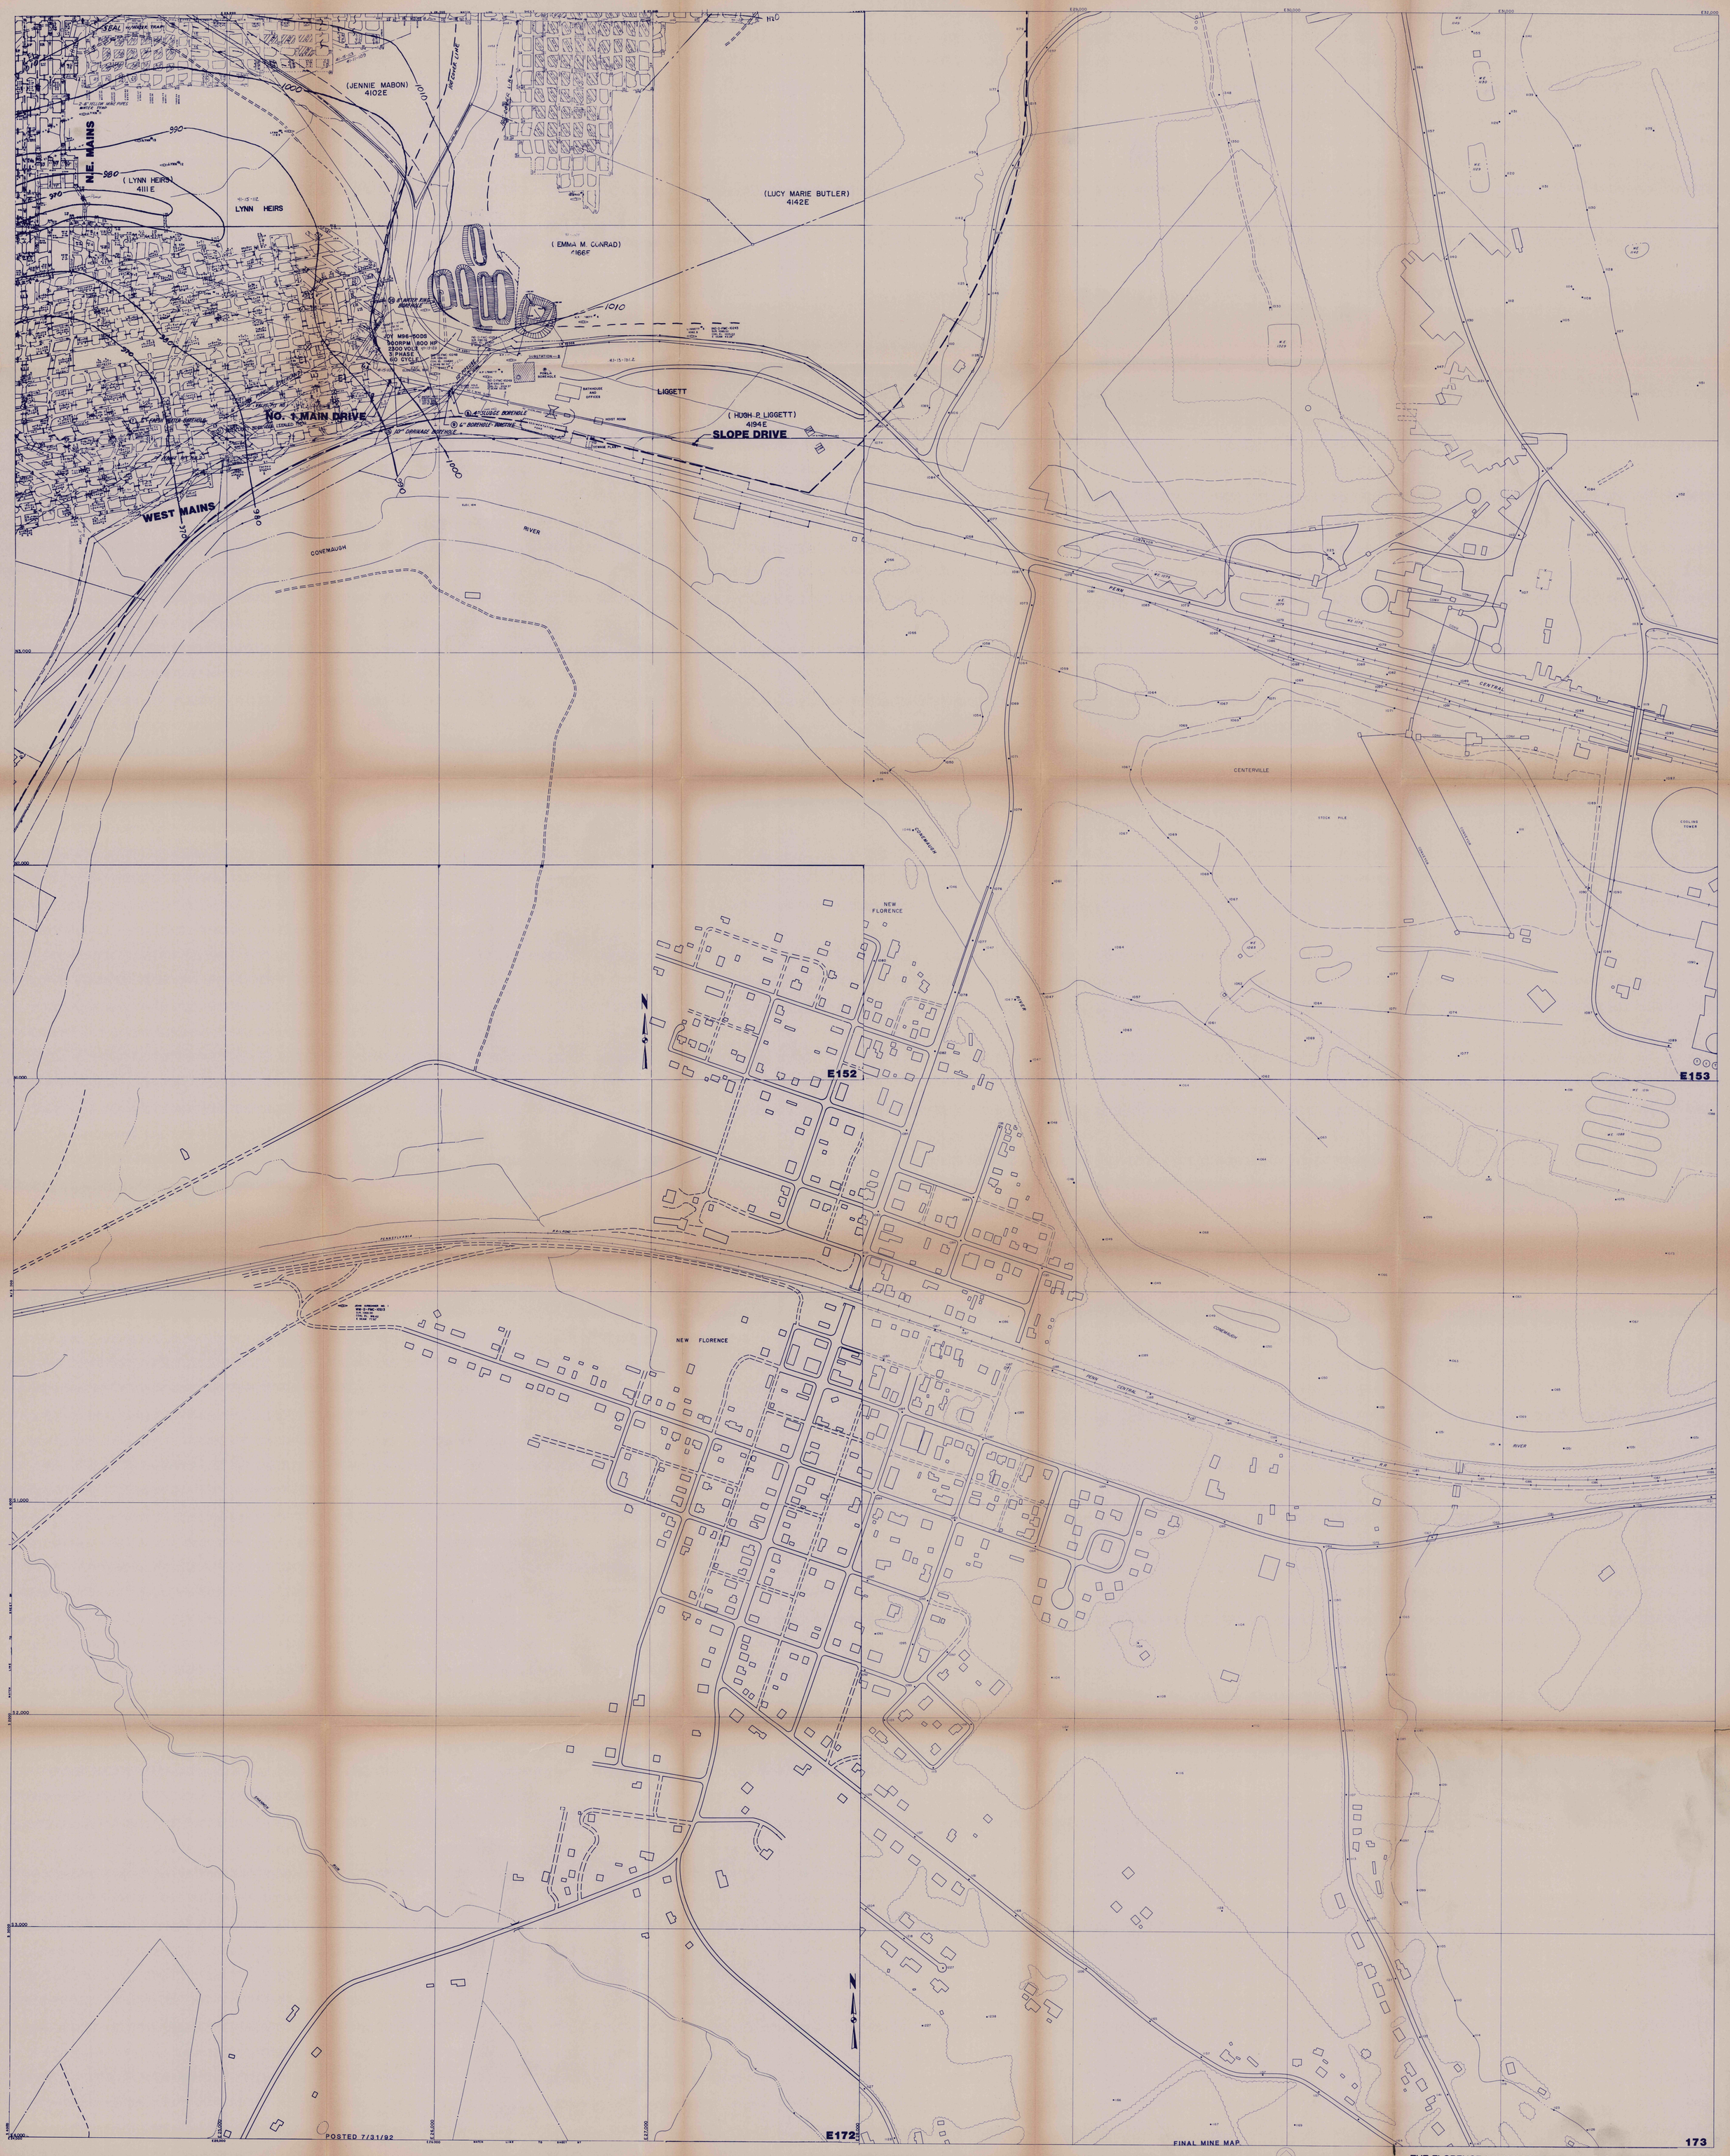

CLOSURE MAP

THE FLORENCE MINING COMPANY
UPPER FREEPORT "E" SEAM
WEST WHEATFIELD TOWNSHIP
INDIANA COUNTY, PA
PERMIT NO. 32831308
SCALE: 1"=200'
DATE:

FLORENCE NO. 2 MINE