


FINAL MINE PLAN
SCALE: 1" = 200'
BARRIERS: BARRIERS: WATER MONITORING POINTS:

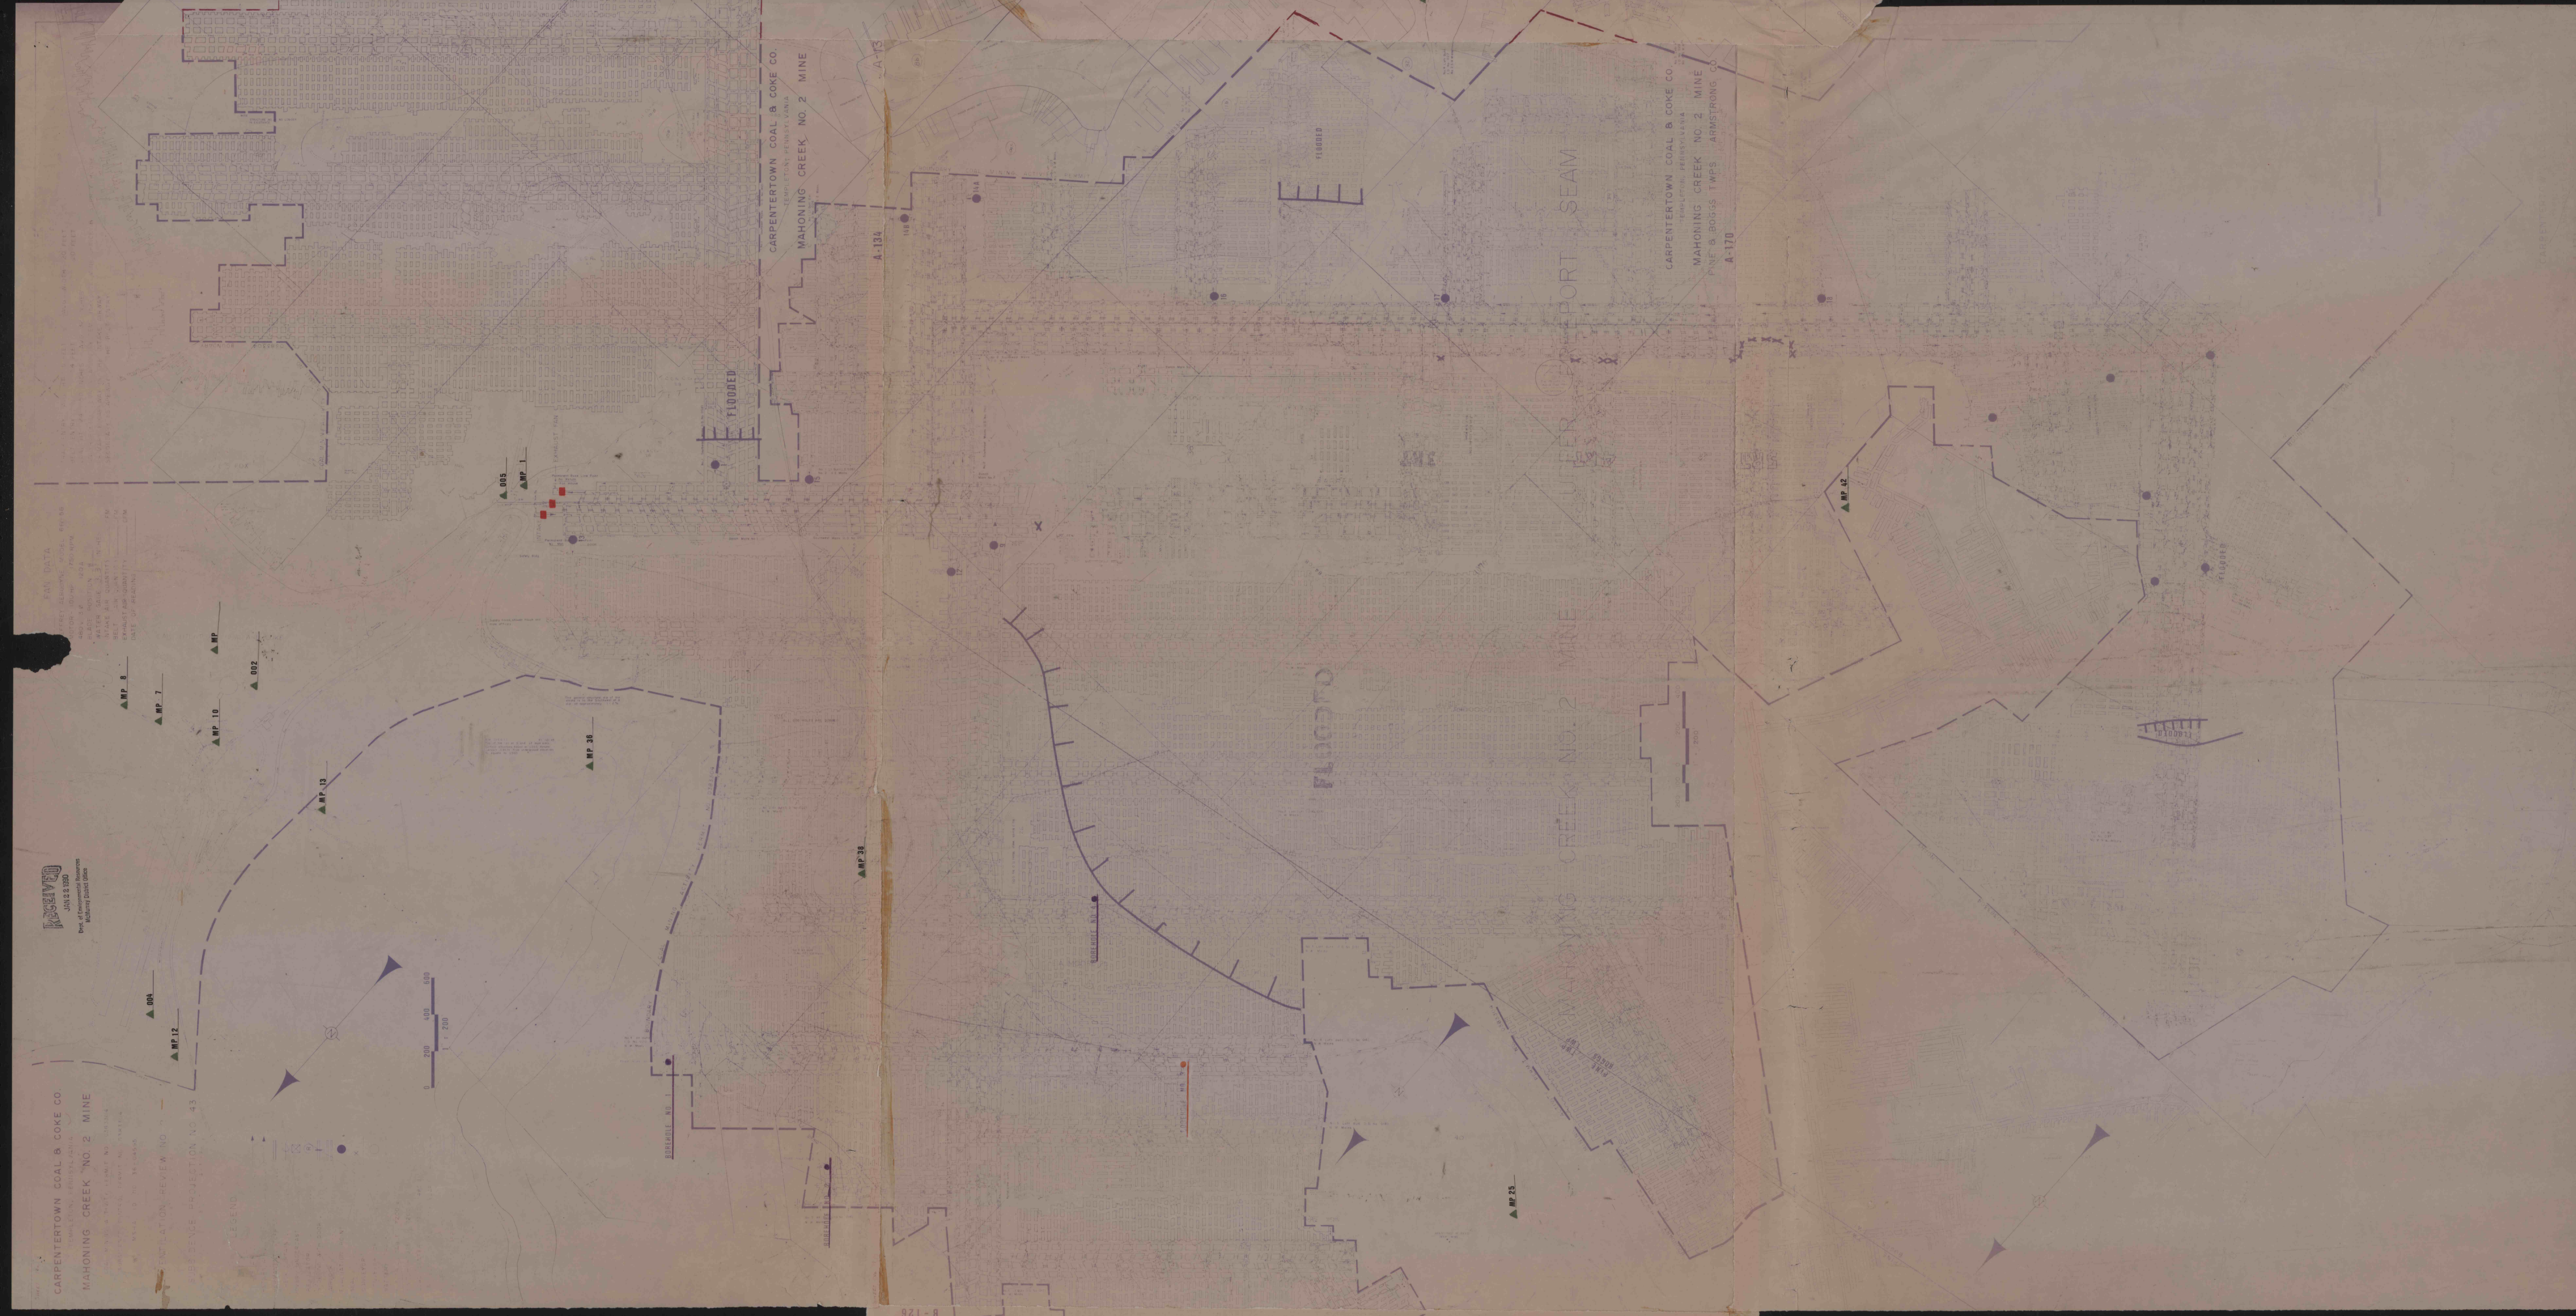

CARPENTERTOWN COAL & COKE CO.
MAHONING CREEK NO. 2 MINE

CARPENTERTOWN COAL & COKE CO.
MAHONING CREEK NO. 2 MINE

