

N 298,000

N 297,000

N 296,000

N 295,000

E 1,635,000

MSHA I.D. No. 36-06583 CMAP No. 33841303



Doverspike Bros. Coal Co.  
R.D. #4, Box 271, Punxsutawney, PA 15767  
Porter & Perry Twp., Jefferson County

### DORA #6 MINE

SCALE: 1" = 200' SHEET 3 of 24


Final Mine Map

- |                              |                             |   |
|------------------------------|-----------------------------|---|
| — PERMIT AREA                | ..... GAS LINE              | ◀ MINE OPENINGS, SEALED                                       |
| - - - PROPERTY LINES         | ⊙ GAS WELL                  | — STREAMS   |
| ① PROPERTY OWNERS            | — T L TELE./ELEC. LINES     | ▲ <sub>12</sub> SURVEY STATION                                |
| ② CONT. PROPERTY OWNERS      | ● WATER WELL                | ▨ SUPPORT AREA (No Second Mining)                             |
| ▲ PRE-66 DWELLINGS           | ○ SPRING                    | ▩ L.F. DEEP MINE  |
| ■ DWELLINGS, STRUCTURES      | ⊙ DRILL HOLE                | ▨ ZONE OF POTENTIAL INFLUENCE                                 |
| ⊙ PROT. ACT 54 STRUCTURES    | ▨ IMPOUNDMENT               | ● GAS WELL BARRIER (No Mining Within Barrier Unless Approved) |
| — LK-1480 L.K. COAL CONTOURS | ◇ CEMETERY                  | ⊗ OVERCAST  |
| ▨ L.K. COAL OUTCROP          | ← MINE OPENINGS, NOT SEALED |   |

- INTAKE AIR
- RETURN AIR
- BELT LINE
- STOPPING
- STOPPING W/ DOOR
- CHECK CURTAIN
- REGULATOR
- DOUBLE DOORS
- RUN-THROUGH CHECK
- OVERCAST



SURVEY IS CLOSED LOOP; ACCURACY IS 1:10000  
 INDIVIDUALS RESPONSIBLE FOR INFORMATION:  
 CHARLES ISHMAN, ENGINEER & CHUCK MARTZ, SUPERINTENDENT  
 MAP FULFILLS REQUIREMENTS OF 75.372 & 75.1200  
 NO ADJACENT MINE WORKINGS WITHIN 1000 FEET  
 NO MINE WORKINGS BELOW MINE PROPERTY

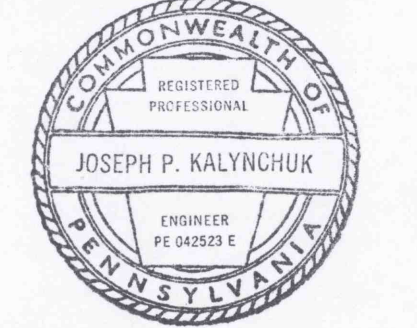

SIGNATURE: *Joseph P. Kalyghuk*  
 DATE: 4-14-99

# FINAL MINE MAP

