

N 298,000

N 297,000

N 296,000

N 295,000

MSHA I.D. No. 36-06583 CMAP No. 33841303



Doverspike Bros. Coal Co.  
R.D. #4, Box 271, Punxsutawney, PA 15767  
Porter & Perry Twp., Jefferson County

# DORA #6 MINE


SCALE: 1" = 200' SHEET 4 of 24

## Final Mine Map

- |                              |                             |   |
|------------------------------|-----------------------------|---|
| — PERMIT AREA                | ..... GAS LINE              | ◀ MINE OPENINGS, SEALED                                       |
| - - - PROPERTY LINES         | ⊙ GAS WELL                  | → RETURN AIR  |
| ① PROPERTY OWNERS            | — T — TELE./ELEC. LINES     | ≡ BELT LINE   |
| ② CONT. PROPERTY OWNERS      | ● WATER WELL                | ≡ STOPPING  |
| ③ PRE-66 DWELLINGS           | ○ SPRING                    | ≡ STOPPING W/ DOOR  |
| ④ DWELLINGS, STRUCTURES      | ⊙ DRILL HOLE                | ⊖ CHECK CURTAIN   |
| ⑤ PROT. ACT 54 STRUCTURES    | ▨ IMPOUNDMENT               | ⊖ REGULATOR   |
| ⑥ LK-1480 L.K. COAL CONTOURS | ◇ CEMETERY                  | ⊖ DOUBLE DOORS  |
| ▨ L.K. COAL OUTCROP          | ◀ MINE OPENINGS, NOT SEALED | ⊖ RUN-THROUGH CHECK   |
|                              |                             | ⊖ OVERCAST  |
|                              |                             | ◀ SURVEY STATION  |
|                              |                             | ▨ SUPPORT AREA (No Second Mining)                             |
|                              |                             | ▨ L.F. DEEP MINE  |
|                              |                             | ● GAS WELL BARRIER (No Mining Within Barrier Unless Approved) |



SURVEY IS CLOSED LOOP; ACCURACY IS 1:10000  
 INDIVIDUALS RESPONSIBLE FOR INFORMATION:  
 CHARLES ISHMAN, ENGINEER & CHUCK MARTZ, SUPERINTENDENT  
 MAP FULFILLS REQUIREMENTS OF 75.372 & 75.1200  
 NO ADJACENT MINE WORKINGS WITHIN 1000 FEET  
 NO MINE WORKINGS BELOW MINE PROPERTY

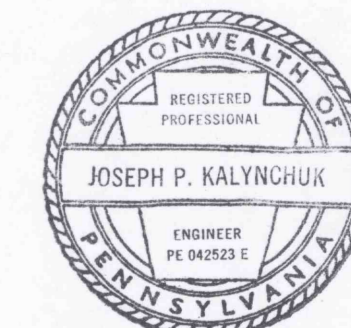

SIGNATURE *Joseph P. Kalynduk*  
 DATE 4-14-99

# FINAL MINE MAP