

MSHA I.D. No. 36-06583 CMAP No. 33841303

Stanford

Doverspike Bros. Coal Co.
 R.D. #4, Box 271, Punxsutawney, PA 15767
 Porter & Perry Twp., Jefferson County


DORA #6 MINE

SCALE: 1" = 200' SHEET 8 of 24

Final Mine Map

- | | | |
|------------------------------|-----------------------------|---|
| — PERMIT AREA | GAS LINE | ← MINE OPENINGS, SEALED |
| - - - PROPERTY LINES | ⊙ GAS WELL | → RETURN AIR |
| ① PROPERTY OWNERS | - T L - TELE./ELEC. LINES | == BELT LINE |
| ② CONT. PROPERTY OWNERS | ● WATER WELL | ≡ STOPPING |
| ▲ PRE-66 DWELLINGS | ○ SPRING | ⊖ STOPPING W/ DOOR |
| ■ DWELLINGS, STRUCTURES | ⊙ DRILL HOLE | ⊕ CHECK CURTAIN |
| ⊙ PROT. ACT 54 STRUCTURES | ▨ IMPOUNDMENT | ⊖ REGULATOR |
| —LK-1480— L.K. COAL CONTOURS | ◇ CEMETERY | ⊖ DOUBLE DOORS |
| ▨ L.K. COAL OUTCROP | ↔ MINE OPENINGS, NOT SEALED | ⊖ RUN-THROUGH CHECK |
| | | ⊖ OVERCAST |
| | | ▲ ₁₂ SURVEY STATION |
| | | ▨ SUPPORT AREA (No Second Mining) |
| | | ▨ L.F. DEEP MINE |
| | | ⊙ ZONE OF POTENTIAL INFLUENCE |
| | | ⊙ GAS WELL BARRIER (No Mining Within Barrier Unless Approved) |
| | | ⊖ |

- ← INTAKE AIR
- RETURN AIR
- == BELT LINE
- ≡ STOPPING
- ⊖ STOPPING W/ DOOR
- ⊕ CHECK CURTAIN
- ⊖ REGULATOR
- ⊖ DOUBLE DOORS
- ⊖ RUN-THROUGH CHECK
- ⊖ OVERCAST

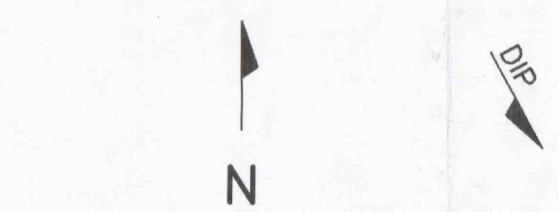

FINAL MINE MAP

SURVEY IS CLOSED LOOP; ACCURACY IS 1:10000
 INDIVIDUALS RESPONSIBLE FOR INFORMATION:
 CHARLES ISHMAN, ENGINEER & CHUCK MARTZ, SUPERINTENDENT
 MAP FULFILLS REQUIREMENTS OF 75.372 & 75.1200
 NO ADJACENT MINE WORKINGS WITHIN 1000 FEET
 NO MINE WORKINGS BELOW MINE PROPERTY



SIGNATURE: *Joseph P. Kalyuchuk*
 DATE: 4-14-99