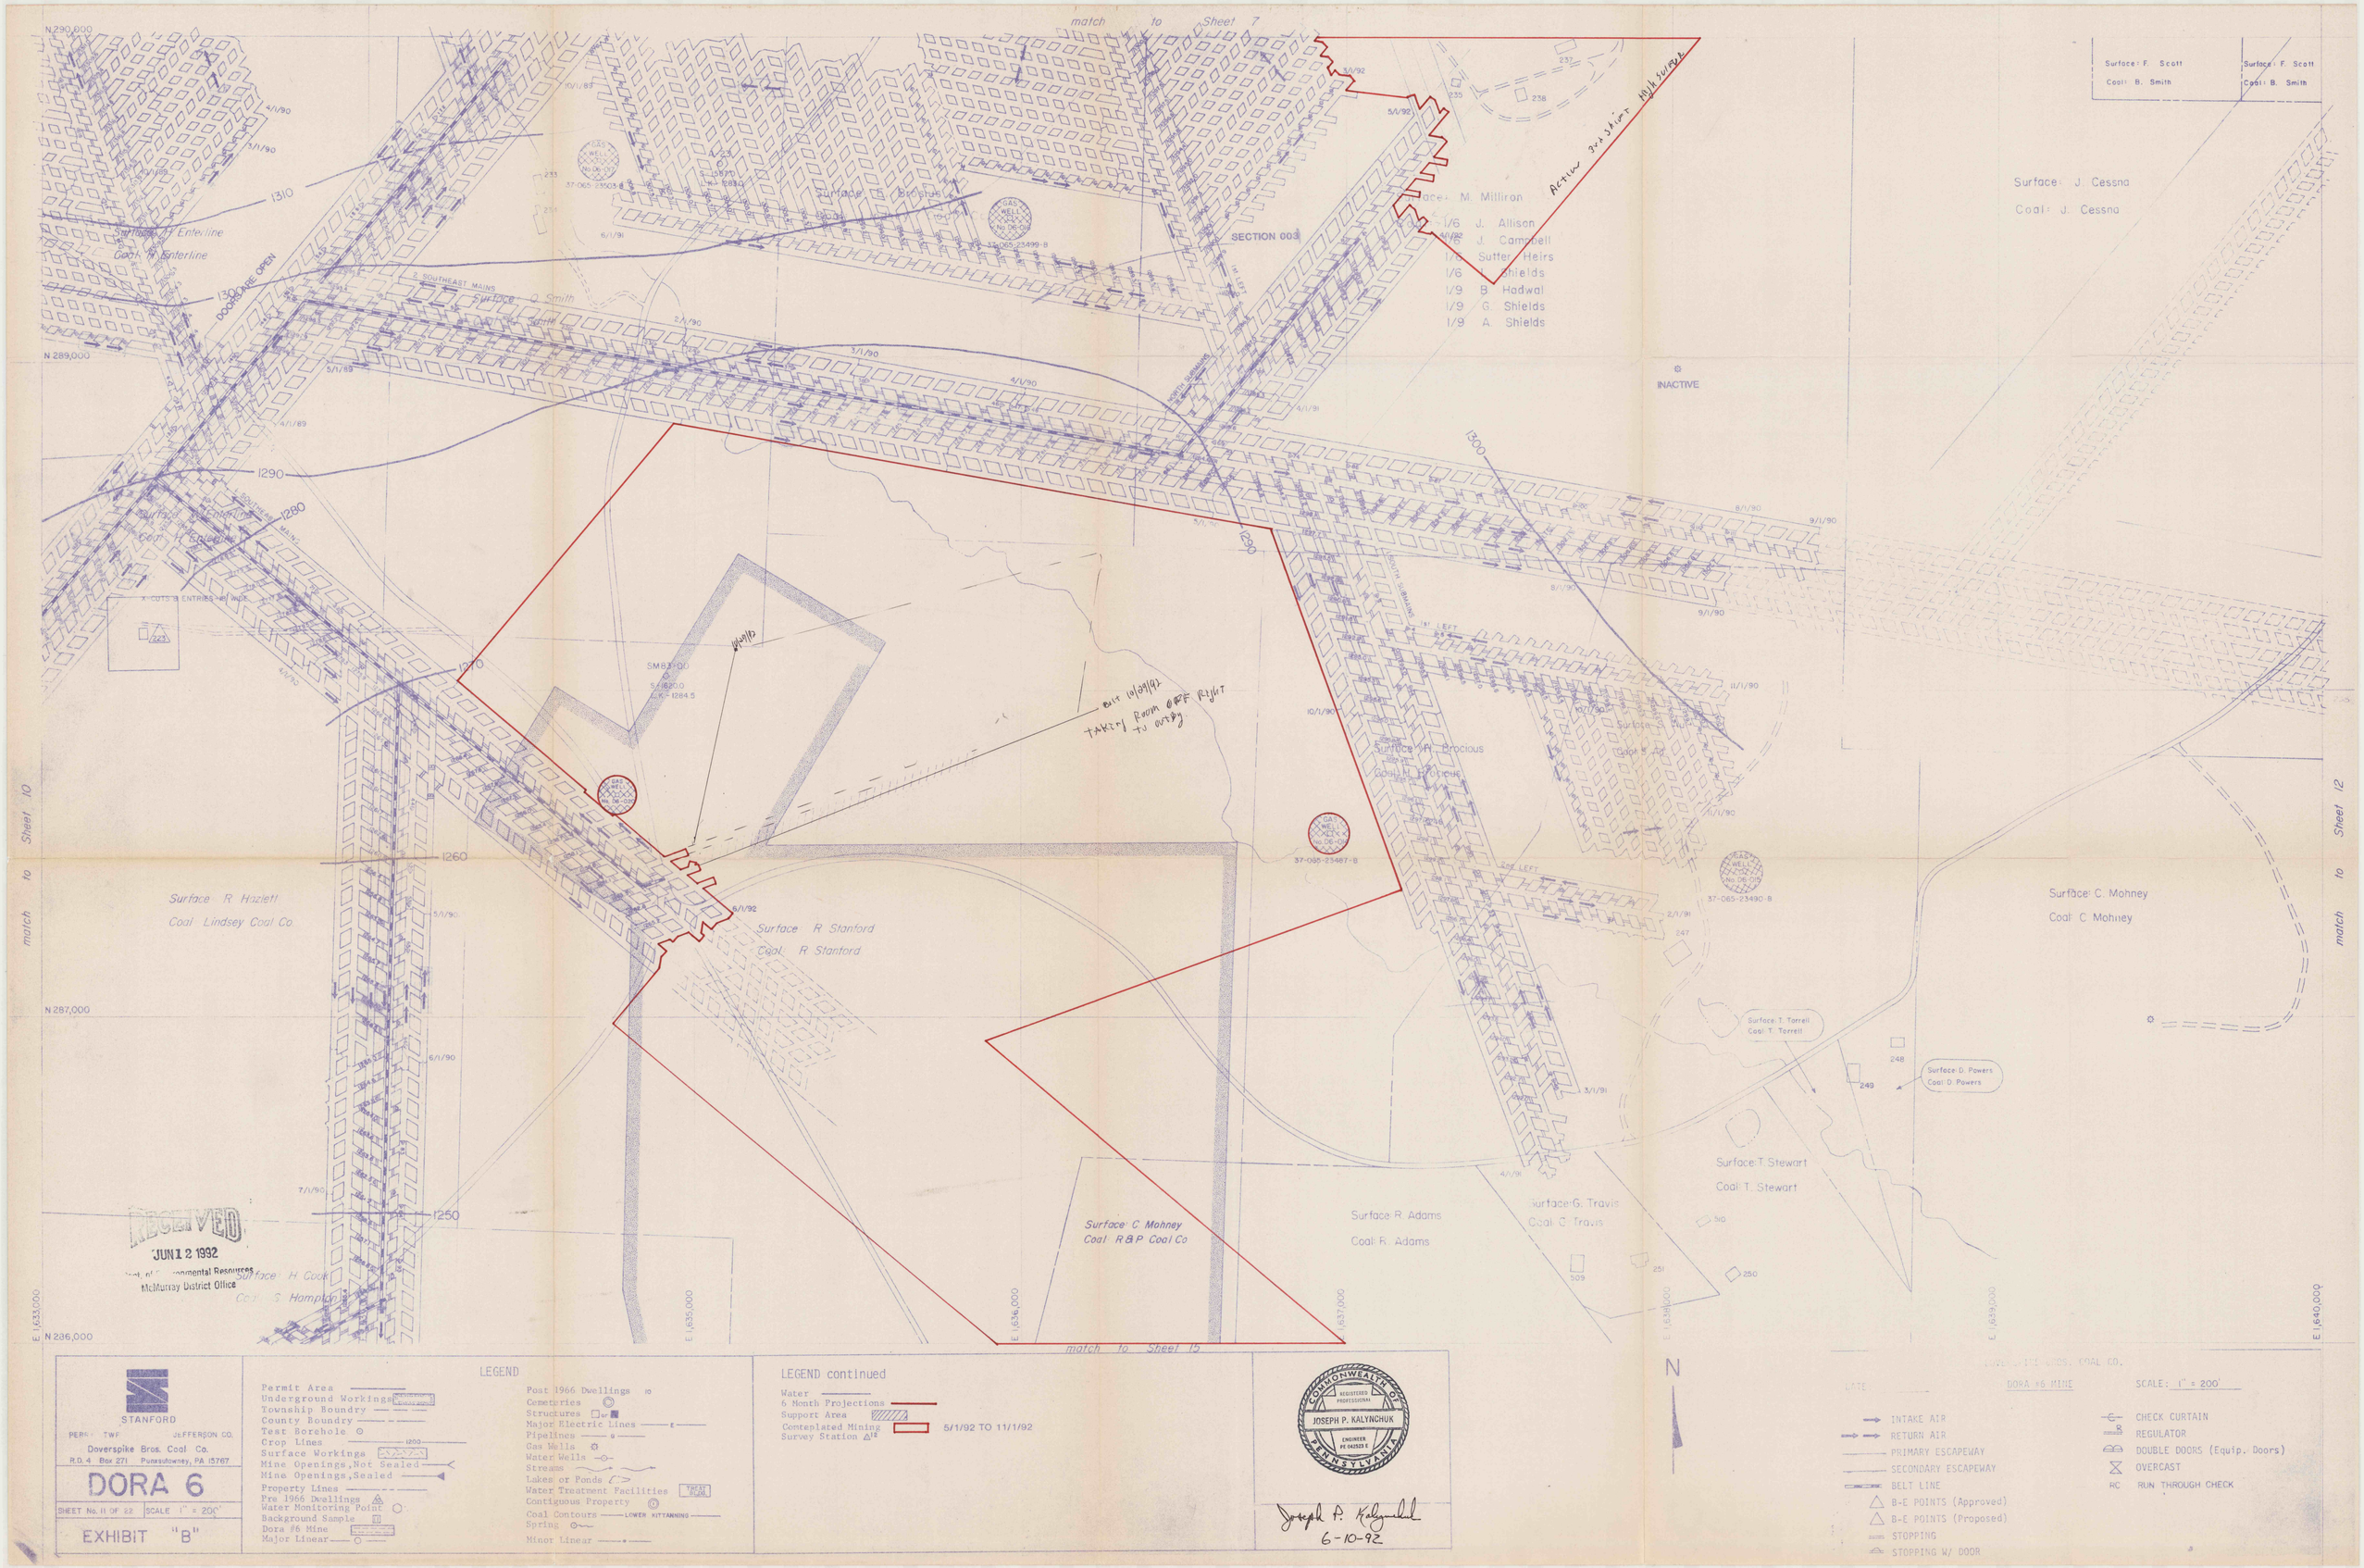

STANFORD

PERRY TWP. JEFFERSON CO.

Doverspike Bros. Coal Co.

R.D. 4 Box 271 Punxsutawney, PA 15767

DORA 6

SHEET No. 11 OF 22 SCALE 1" = 200'

EXHIBIT "B"

LEGEND

- Permit Area
- Underground Workings
- Township Boundry
- County Boundry
- Test Borehole
- Crop Lines
- Surface Workings
- Mine Openings, Not Sealed
- Mine Openings, Sealed
- Property Lines
- Pre 1966 Dwellings
- Water Monitoring Point
- Background Sample
- Dora #6 Mine
- Major Linear
- Post 1966 Dwellings
- Cemeteries
- Structures
- Major Electric Lines
- Pipelines
- Gas Wells
- Water Wells
- Streams
- Lakes or Ponds
- Water Treatment Facilities
- Contiguous Property
- Coal Contours — LOWER KITTANNING
- Spring
- Minor Linear

LEGEND continued

- Water
- 6 Month Projections
- Support Area
- Comteplated Mining
- Survey Station

5/1/92 TO 11/1/92

COMMONWEALTH OF PENNSYLVANIA
REGISTERED PROFESSIONAL
JOSEPH P. KALYNCHUK
ENGINEER
PE 042523 E

Joseph P. Kalynchuk
6-10-92

N

DOVERSPIKE BROS. COAL CO.

DATE:

DORA #6 MINE

SCALE: 1" = 200'

- INTAKE AIR
- RETURN AIR
- PRIMARY ESCAPEWAY
- SECONDARY ESCAPEWAY
- BELT LINE
- B-E POINTS (Approved)
- B-E POINTS (Proposed)
- STOPPING
- STOPPING W/ DOOR
- CHECK CURTAIN
- REGULATOR
- DOUBLE DOORS (Equip. Doors)
- OVERCAST
- RC RUN THROUGH CHECK