

N 290,000

DH-13  
-1700.0  
-1318.1

45

SM85-009  
S-1700.0  
LK-1349.5

55

N 289,000

54

BOREHOLE "F"  
DIA = 1.9810  
DIA = 5/8" DIAMETER

2 WEST SUBMAINS

2 WEST SUBMAINS


A16  
S-1658.0  
LK-1327.5

79-112  
S-1630.0  
LK-1327.2

102  
INACTIVE

62  
63

MSHA I.D. No. 36-06583 CMAP No. 33841303

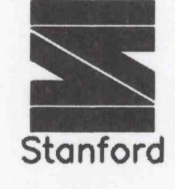

Doverspike Bros. Coal Co.  
R.D. #4, Box 271, Punxsutawney, PA 15767  
Porter & Perry Twp., Jefferson County

DORA #6 MINE

SCALE: 1" = 200' SHEET 10 of 24

Final Mine Map

- PERMIT AREA
- - - PROPERTY LINES
- (3) PROPERTY OWNERS
- (9) CONT. PROPERTY OWNERS
- ▲ PRE-66 DWELLINGS
- DWELLINGS, STRUCTURES
- ▣ PROT. ACT 54 STRUCTURES
- LK-1480- L.K. COAL CONTOURS
- ▨ L.K. COAL OUTCROP
- ..... GAS LINE
- ⊙ GAS WELL
- T L- TELE./ELEC. LINES
- WATER WELL
- SPRING
- DRILL HOLE
- ▨ IMPOUNDMENT
- ◇ CEMETERY
- MINE OPENINGS, NOT SEALED
- MINE OPENINGS, SEALED
- STREAMS
- ▲ SURVEY STATION
- ▨ SUPPORT AREA (No Second Mining)
- ▨ L.F. DEEP MINE
- ▨ ZONE OF POTENTIAL INFLUENCE
- ⊙ GAS WELL BARRIER (No Mining Within Barrier Unless Approved)


- INTAKE AIR
- ← RETURN AIR
- BELT LINE
- STOPPING
- STOPPING W/ DOOR
- CHECK CURTAIN
- REGULATOR
- DOUBLE DOORS
- RUN-THROUGH CHECK
- OVERCAST





SURVEY IS CLOSED LOOP; ACCURACY IS 1:10000  
INDIVIDUALS RESPONSIBLE FOR INFORMATION:  
CHARLES ISHMAN, ENGINEER & CHUCK MARTZ, SUPERINTENDENT  
MAP FULFILLS REQUIREMENTS OF 75.372 & 75.1200  
NO ADJACENT MINE WORKINGS WITHIN 1000 FEET  
NO MINE WORKINGS BELOW MINE PROPERTY

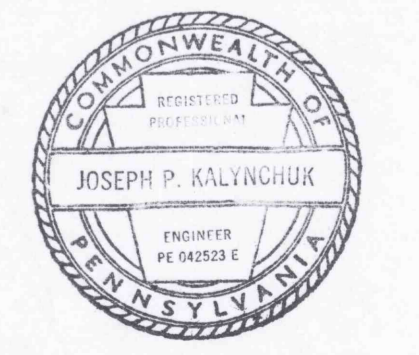

SIGNATURE: Joseph P. Kalynchuk  
DATE: 4-14-99

# FINAL MINE MAP