

MSHA I.D. No. 36-05583 CMAP No. 33841303



Doverspike Bros. Coal Co.  
R.D. #4, Box 271, Punxsutawney, PA 15767  
Porter & Perry Twp., Jefferson County


**DORA #6 MINE**

SCALE: 1" = 200' SHEET 11 of 24

Final Mine Map

- |                                |                             |   |
|--------------------------------|-----------------------------|---|
| — PERMIT AREA                  | ..... GAS LINE              | — MINE OPENINGS, SEALED                                       |
| - - - PROPERTY LINES           | ⊙ GAS WELL                  | — STREAMS   |
| ① PROPERTY OWNERS              | — T — TELE./ELEC. LINES     | • SURVEY STATION  |
| ② CONT. PROPERTY OWNERS        | • WATER WELL                | ▨ SUPPORT AREA (No Second Mining)                             |
| ■ PRE-66 DWELLINGS             | ○ SPRING                    | ▩ L.F. DEEP MINE  |
| ▩ DWELLINGS, STRUCTURES        | ⊙ DRILL HOLE                | ▨ ZONE OF POTENTIAL INFLUENCE                                 |
| ▩ PROT. ACT 54 STRUCTURES      | ⊙ IMPOUNDMENT               | ⊙ GAS WELL BARRIER (No Mining Within Barrier Unless Approved) |
| — LK-1480 — L.K. COAL CONTOURS | ◇ CEMETERY                  | — MINE OPENINGS, NOT SEALED                                   |
| ▨ L.K. COAL OUTCROP            | — MINE OPENINGS, NOT SEALED |   |

- |                     |
|---------------------|
| → INTAKE AIR        |
| ← RETURN AIR        |
| — BELT LINE         |
| — STOPPING          |
| — STOPPING W/ DOOR  |
| — CHECK CURTAIN     |
| — REGULATOR         |
| — DOUBLE DOORS      |
| — RUN-THROUGH CHECK |
| — OVERCAST          |

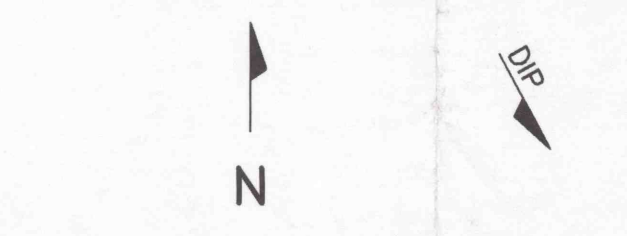

SURVEY IS CLOSED LOOP; ACCURACY IS 1:10000  
INDIVIDUALS RESPONSIBLE FOR INFORMATION:  
CHARLES ISHMAN, ENGINEER & CHUCK MARTZ, SUPERINTENDENT  
MAP FULFILLS REQUIREMENTS OF 75.372 & 75.1200  
NO ADJACENT MINE WORKINGS WITHIN 1000 FEET  
NO MINE WORKINGS BELOW MINE PROPERTY



SIGNATURE: *Joseph P. Kalyushuk*  
DATE: 4-14-99

**FINAL MINE MAP**