


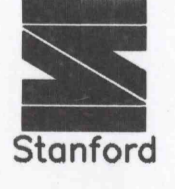

MSHA I.D. No. 36-06583 CMAP No. 33841303



**Doverspike Bros. Coal Co.**  
R.D. #4, Box 271, Punxsutawney, PA 15767  
Porter & Perry Twp., Jefferson County

**DORA #6 MINE**


SCALE: 1" = 200' SHEET 13 of 24

**Final Mine Map**

<ul style="list-style-type: none"> <li>— PERMIT AREA</li> <li>- - - PROPERTY LINES</li> <li>① PROPERTY OWNERS</li> <li>② CONT. PROPERTY OWNERS</li> <li>■ PRE-66 DWELLINGS</li> <li>■ DWELLINGS, STRUCTURES</li> <li>⊙ PROT. ACT 54 STRUCTURES</li> <li>-LK-1480- L.K. COAL CONTOURS</li> <li>▨ L.K. COAL OUTCROP</li> </ul>	<ul style="list-style-type: none"> <li>⋯ GAS LINE</li> <li>⊙ GAS WELL</li> <li>-T L- TELE./ELEC. LINES</li> <li>● WATER WELL</li> <li>○ SPRING</li> <li>⊙ DRILL HOLE</li> <li>▨ IMPOUNDMENT</li> <li>◇ CEMETERY</li> <li>⋯ MINE OPENINGS, NOT SEALED</li> </ul>	<ul style="list-style-type: none"> <li>⊙ MINE OPENINGS, SEALED</li> <li>⋯ STREAMS</li> <li>⊙ SURVEY STATION</li> <li>▨ SUPPORT AREA (No Second Mining)</li> <li>▨ L.F. DEEP MINE</li> <li>▨ ZONE OF POTENTIAL INFLUENCE</li> <li>⊙ GAS WELL BARRIER (No Mining Within Barrier Unless Approved)</li> <li>⋯</li> </ul>	<ul style="list-style-type: none"> <li>→ INTAKE AIR</li> <li>← RETURN AIR</li> <li>— BELT LINE</li> <li>— STOPPING</li> <li>— STOPPING W/ DOOR</li> <li>⊙ CHECK CURTAIN</li> <li>⊙ REGULATOR</li> <li>⊙ DOUBLE DOORS</li> <li>⊙ RUN-THROUGH CHECK</li> <li>⊙ OVERCAST</li> </ul>
--	---	--	--

SURVEY IS CLOSED LOOP; ACCURACY IS 1:10000

INDIVIDUALS RESPONSIBLE FOR INFORMATION:  
CHARLES ISHMAN, ENGINEER & CHUCK MARTZ, SUPERINTENDENT  
MAP FULFILLS REQUIREMENTS OF 75.372 & 75.1200  
NO ADJACENT MINE WORKINGS WITHIN 1000 FEET  
NO MINE WORKINGS BELOW MINE PROPERTY

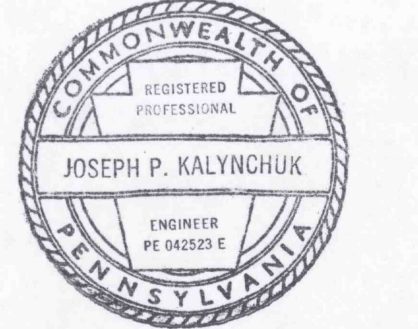

SIGNATURE *Joseph P. Kalyanchuk*  
DATE 4-14-99

# FINAL MINE MAP