

MSHA I.D. No. 36-06583 CMAP No. 33841303



Doverspike Bros. Coal Co.
R.D. #4, Box 271, Punxsutawney, PA 15767
Porter & Perry Twp., Jefferson County


DORA #6 MINE

SCALE: 1" = 200' SHEET 14 of 24


Final Mine Map

- | | | |
|--------------------------------|-------------------------|---|
| — PERMIT AREA | GAS LINE | — MINE OPENINGS, SEALED |
| - - - PROPERTY LINES | ⊛ GAS WELL | STREAMS |
| Ⓢ PROPERTY OWNERS | — T — TELE./ELEC. LINES | ▲ ₁₂ SURVEY STATION |
| Ⓣ CONT. PROPERTY OWNERS | ● WATER WELL | ▨ SUPPORT AREA (No Second Mining) |
| Ⓜ PRE-66 DWELLINGS | ○ SPRING | ▩ L.F. DEEP MINE |
| Ⓜ DWELLINGS, STRUCTURES | ⊙ DRILL HOLE | ▩ ZONE OF POTENTIAL INFLUENCE |
| Ⓜ PROT. ACT 54 STRUCTURES | ▨ IMPOUNDMENT | ● GAS WELL BARRIER (No Mining Within Barrier Unless Approved) |
| — LK-1480 — L.K. COAL CONTOURS | ◇ CEMETERY | — MINE OPENINGS, NOT SEALED |
| ▨ L.K. COAL OUTCROP | | |

- | |
|---------------------|
| → INTAKE AIR |
| ← RETURN AIR |
| — BELT LINE |
| — STOPPING |
| — STOPPING W/ DOOR |
| ⊙ CHECK CURTAIN |
| ⊙ REGULATOR |
| ⊙ DOUBLE DOORS |
| ⊙ RUN-THROUGH CHECK |
| ⊙ OVERCAST |

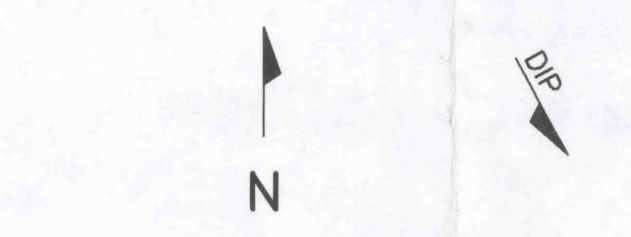

SURVEY IS CLOSED LOOP; ACCURACY IS 1:10000
INDIVIDUALS RESPONSIBLE FOR INFORMATION:
CHARLES ISHMAN, ENGINEER & CHUCK MARTZ, SUPERINTENDENT
MAP FULFILLS REQUIREMENTS OF 75.372 & 75.1200
NO ADJACENT MINE WORKINGS WITHIN 1000 FEET
NO MINE WORKINGS BELOW MINE PROPERTY

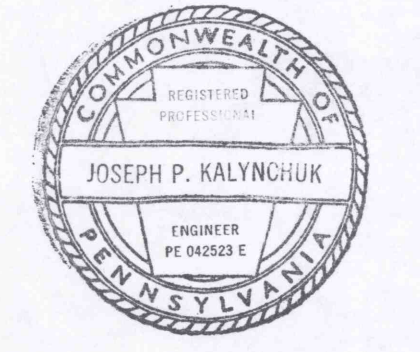

SIGNATURE *Joseph P. Kalyndjuk*
DATE 4-14-99

FINAL MINE MAP