


N 286,000

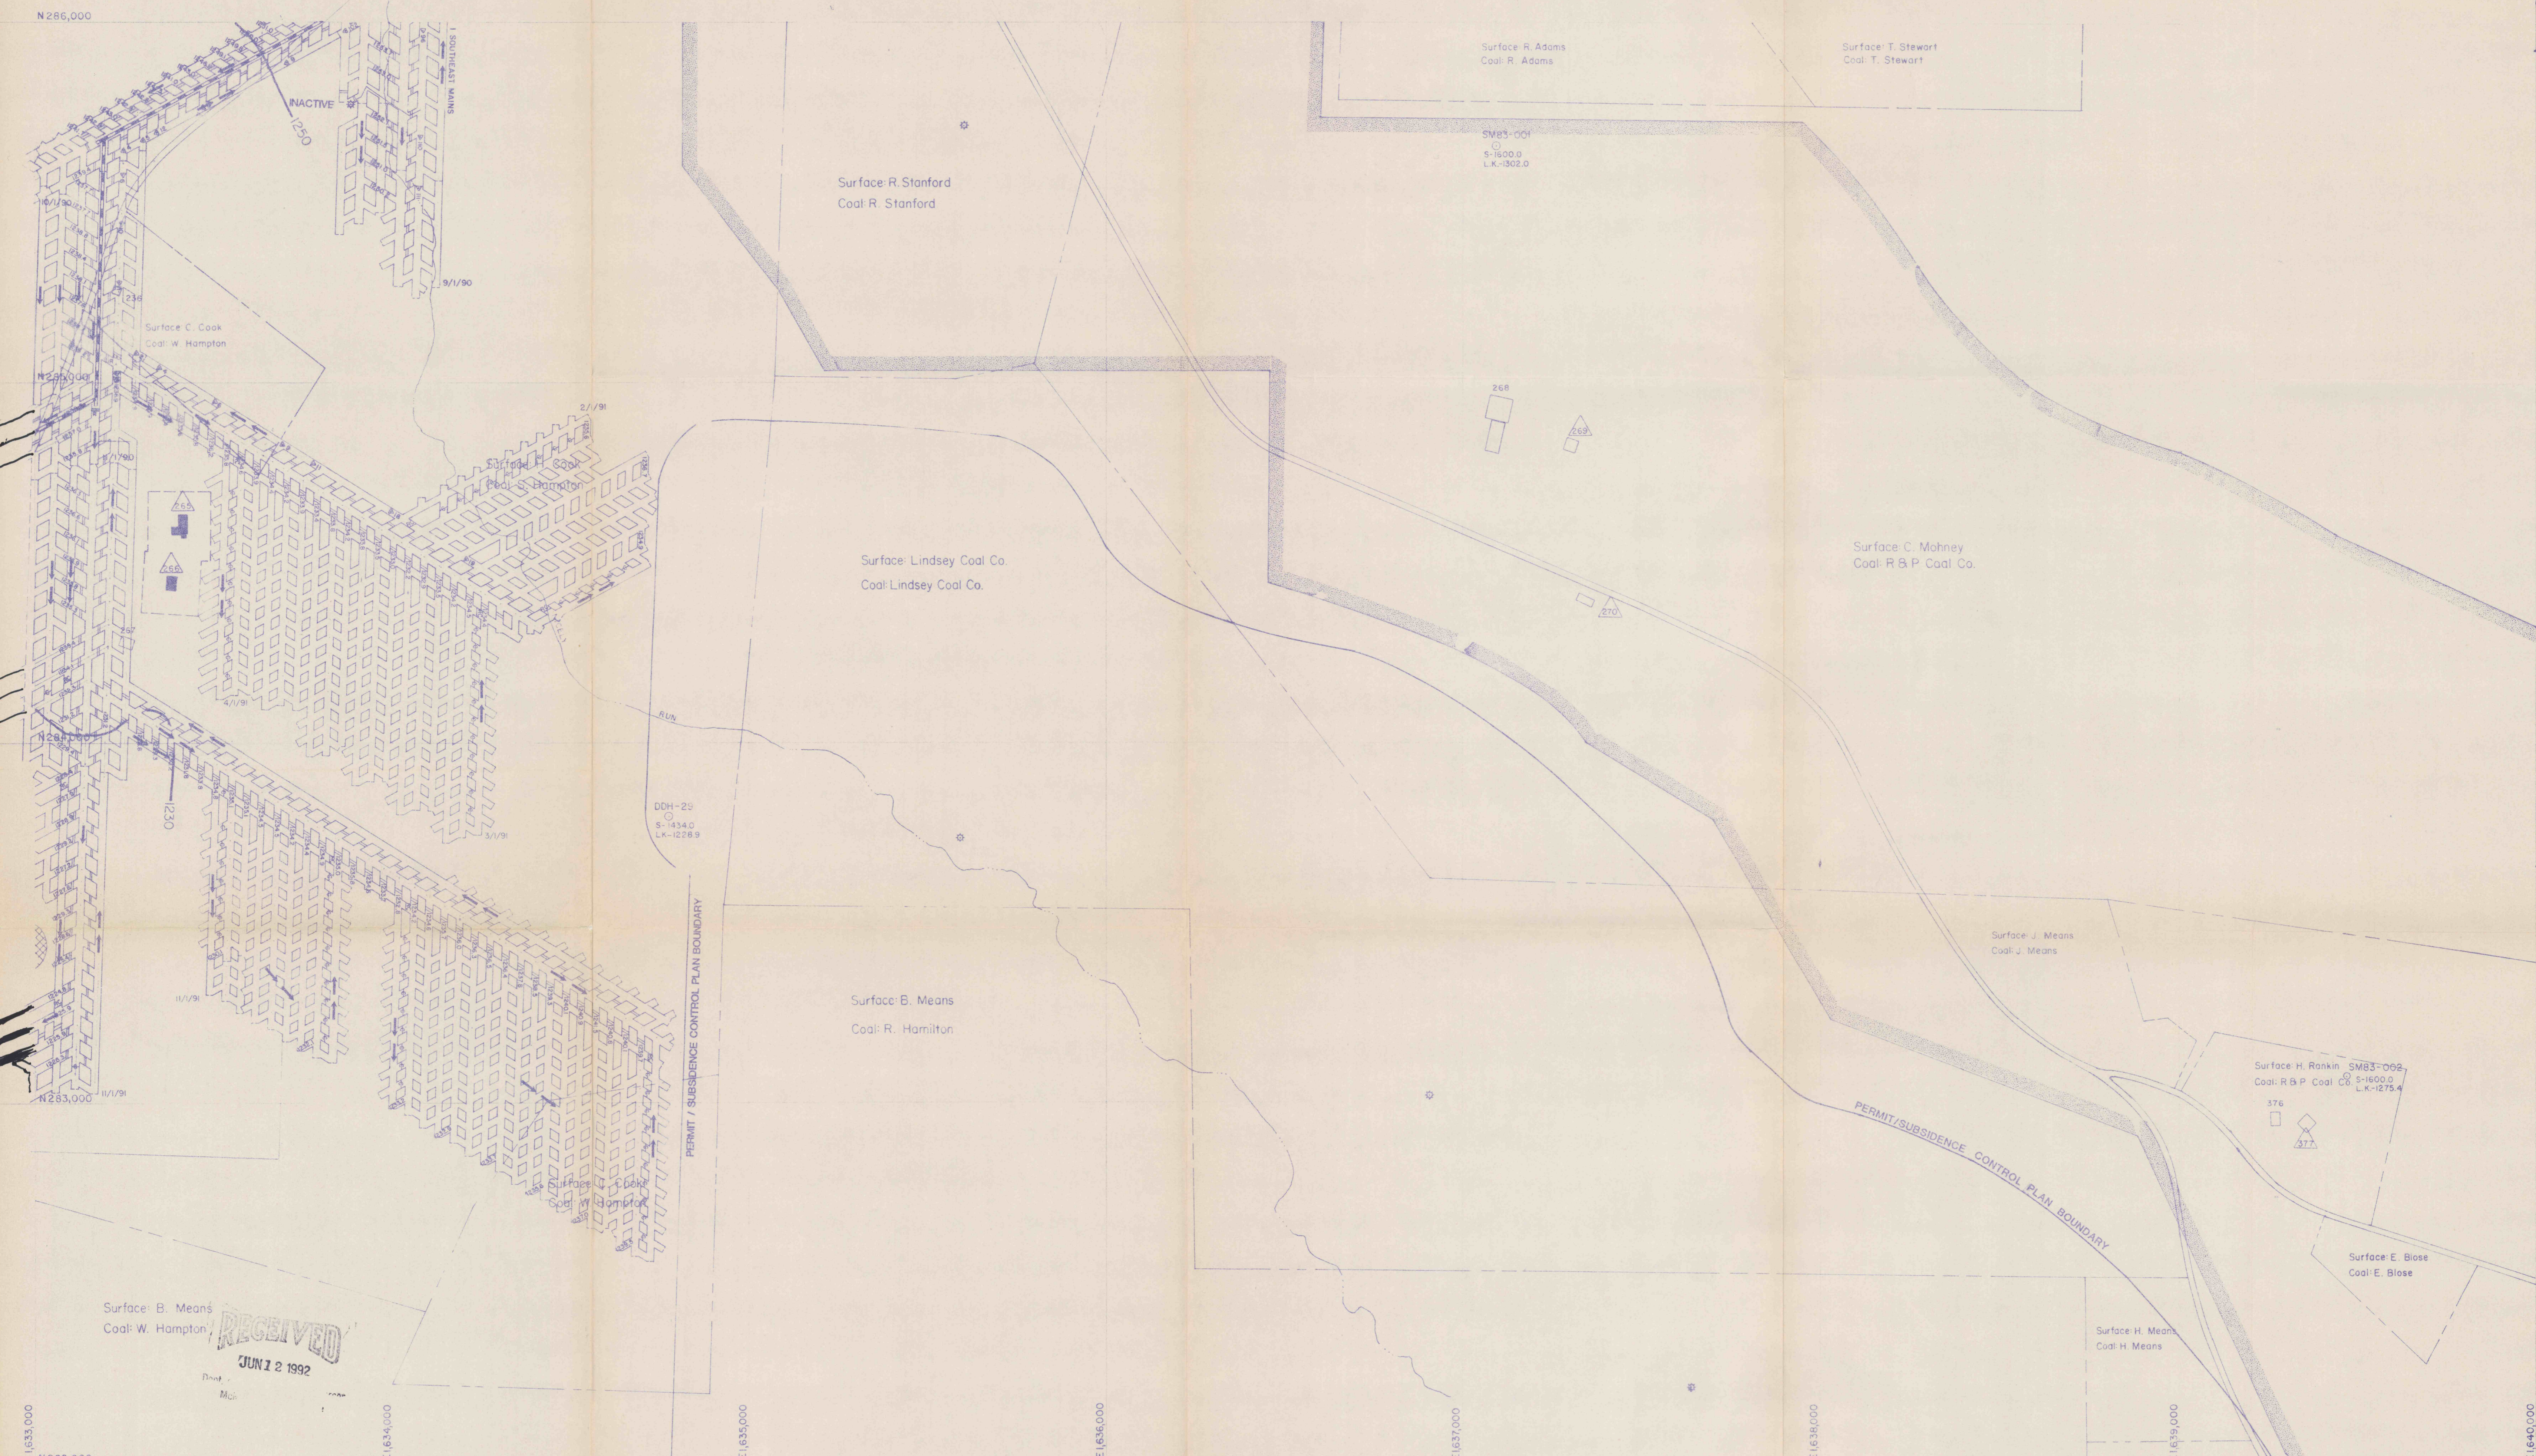

Surface: B. Means  
Coal: W. Hampton

**RECEIVED**  
JUN 2 1992

E 1633,000    E 1634,000    E 1635,000    E 1636,000    E 1637,000    E 1638,000    E 1639,000    E 1640,000

N 282,000    N 283,000    N 284,000    N 285,000    N 286,000    N 287,000    N 288,000    N 289,000

**STANFORD**

PERRY TWP.    JEFFERSON CO.  
Doverspike Bros. Coal Co.  
R.D. 4 Box 271    Pottsville, PA 17567

**DORA - 6**

SHEET No. 15 OF 22    SCALE 1" = 200'

**EXHIBIT "B"**

**LEGEND**

Permit Area  
Underground Workings  
Township Boundary  
County Boundary  
Test Borehole  
Crop Lines  
Surface Workings  
Mine Openings, Not Sealed  
Mine Openings, Sealed  
Property Lines  
Pre 1966 Dwellings  
Water Monitoring Point  
Background Sample  
Dora # Mine  
Major Linear

Post 1966 Dwellings  
Cemeteries  
Structures  
Major Electric Lines  
Pipelines  
Gas Wells  
Water Wells  
Streams  
Lakes or Ponds  
Water Treatment Facilities  
Contiguous Property  
Coal Contours - LOWER KITTANNING  
Spring  
Minor Linear

**LEGEND continued**

Water  
6 Month Projections  
Support Area  
Contemplated Mining  
Survey Station  
Gas Well Barrier

5/1/92    11/1/92

COMMONWEALTH OF PENNSYLVANIA  
REGISTERED PROFESSIONAL ENGINEER  
**JOSEPH P. KALYNCHUK**  
ENGINEER  
PE 042522 C

*Joseph P. Kalynchuk*  
6-10-92



DORA #6 MINE    SCALE: 1" = 200'

DATE: \_\_\_\_\_

INTAKE AIR  
RETURN AIR  
PRIMARY ESCAPEWAY  
SECONDARY ESCAPEWAY  
BELT LINE  
B-E POINTS (Approved)  
B-E POINTS (Proposed)  
STOPPING

STOPPING W/ DOOR  
CHECK CURTAIN  
REGULATOR  
DOUBLE DOORS (Equip. doors)  
OVERCAST  
RUN THROUGH CHECK