

MSHA I.D. No. 36-06583 CMAP No. 33841303

Stanford

Doverspike Bros. Coal Co.
R.D. #4, Box 271, Punxsutawney, PA 15767
Porter & Perry Twp., Jefferson County

DORA #6 MINE

SCALE: 1" = 200' SHEET 16 of 24

Final Mine Map

- | | | | |
|--|---|---|--|
| <ul style="list-style-type: none"> — PERMIT AREA - - - PROPERTY LINES ① PROPERTY OWNERS ② CONT. PROPERTY OWNERS PRE-66 DWELLINGS DWELLINGS, STRUCTURES PROT. ACT 54 STRUCTURES -LK-1480- L.K. COAL CONTOURS L.K. COAL OUTCROP | <ul style="list-style-type: none"> GAS LINE ⊙ GAS WELL -T- L TELE./ELEC. LINES ● WATER WELL ○ SPRING ○ DRILL HOLE IMPOUNDMENT CEMETERY MINE OPENINGS, NOT SEALED | <ul style="list-style-type: none"> ◀ MINE OPENINGS, SEALED — STREAMS ▲ SURVEY STATION SUPPORT AREA (No Second Mining) L.F. DEEP MINE ZONE OF POTENTIAL INFLUENCE GAS WELL BARRIER (No Mining Within Barrier Unless Approved) | <ul style="list-style-type: none"> → INTAKE AIR ← RETURN AIR BELT LINE STOPPING STOPPING W/ DOOR CHECK CURTAIN REGULATOR DOUBLE DOORS RUN-THROUGH CHECK OVERCAST |
|--|---|---|--|


SURVEY IS CLOSED LOOP; ACCURACY IS 1:10000

INDIVIDUALS RESPONSIBLE FOR INFORMATION:
CHARLES ISHMAN, ENGINEER & CHUCK MARTZ, SUPERINTENDENT

MAP FULFILLS REQUIREMENTS OF 75.372 & 75.1200

NO ADJACENT MINE WORKINGS WITHIN 1000 FEET

NO MINE WORKINGS BELOW MINE PROPERTY

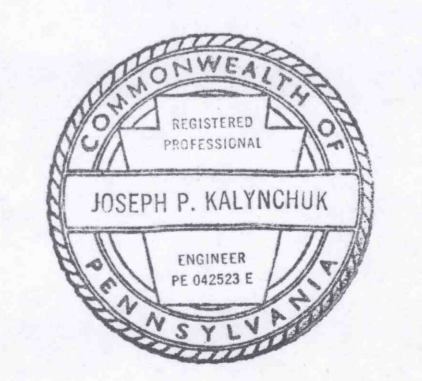

FINAL MINE MAP

SIGNATURE: *Joseph P. Kalyanchuk*

DATE: 4-14-99