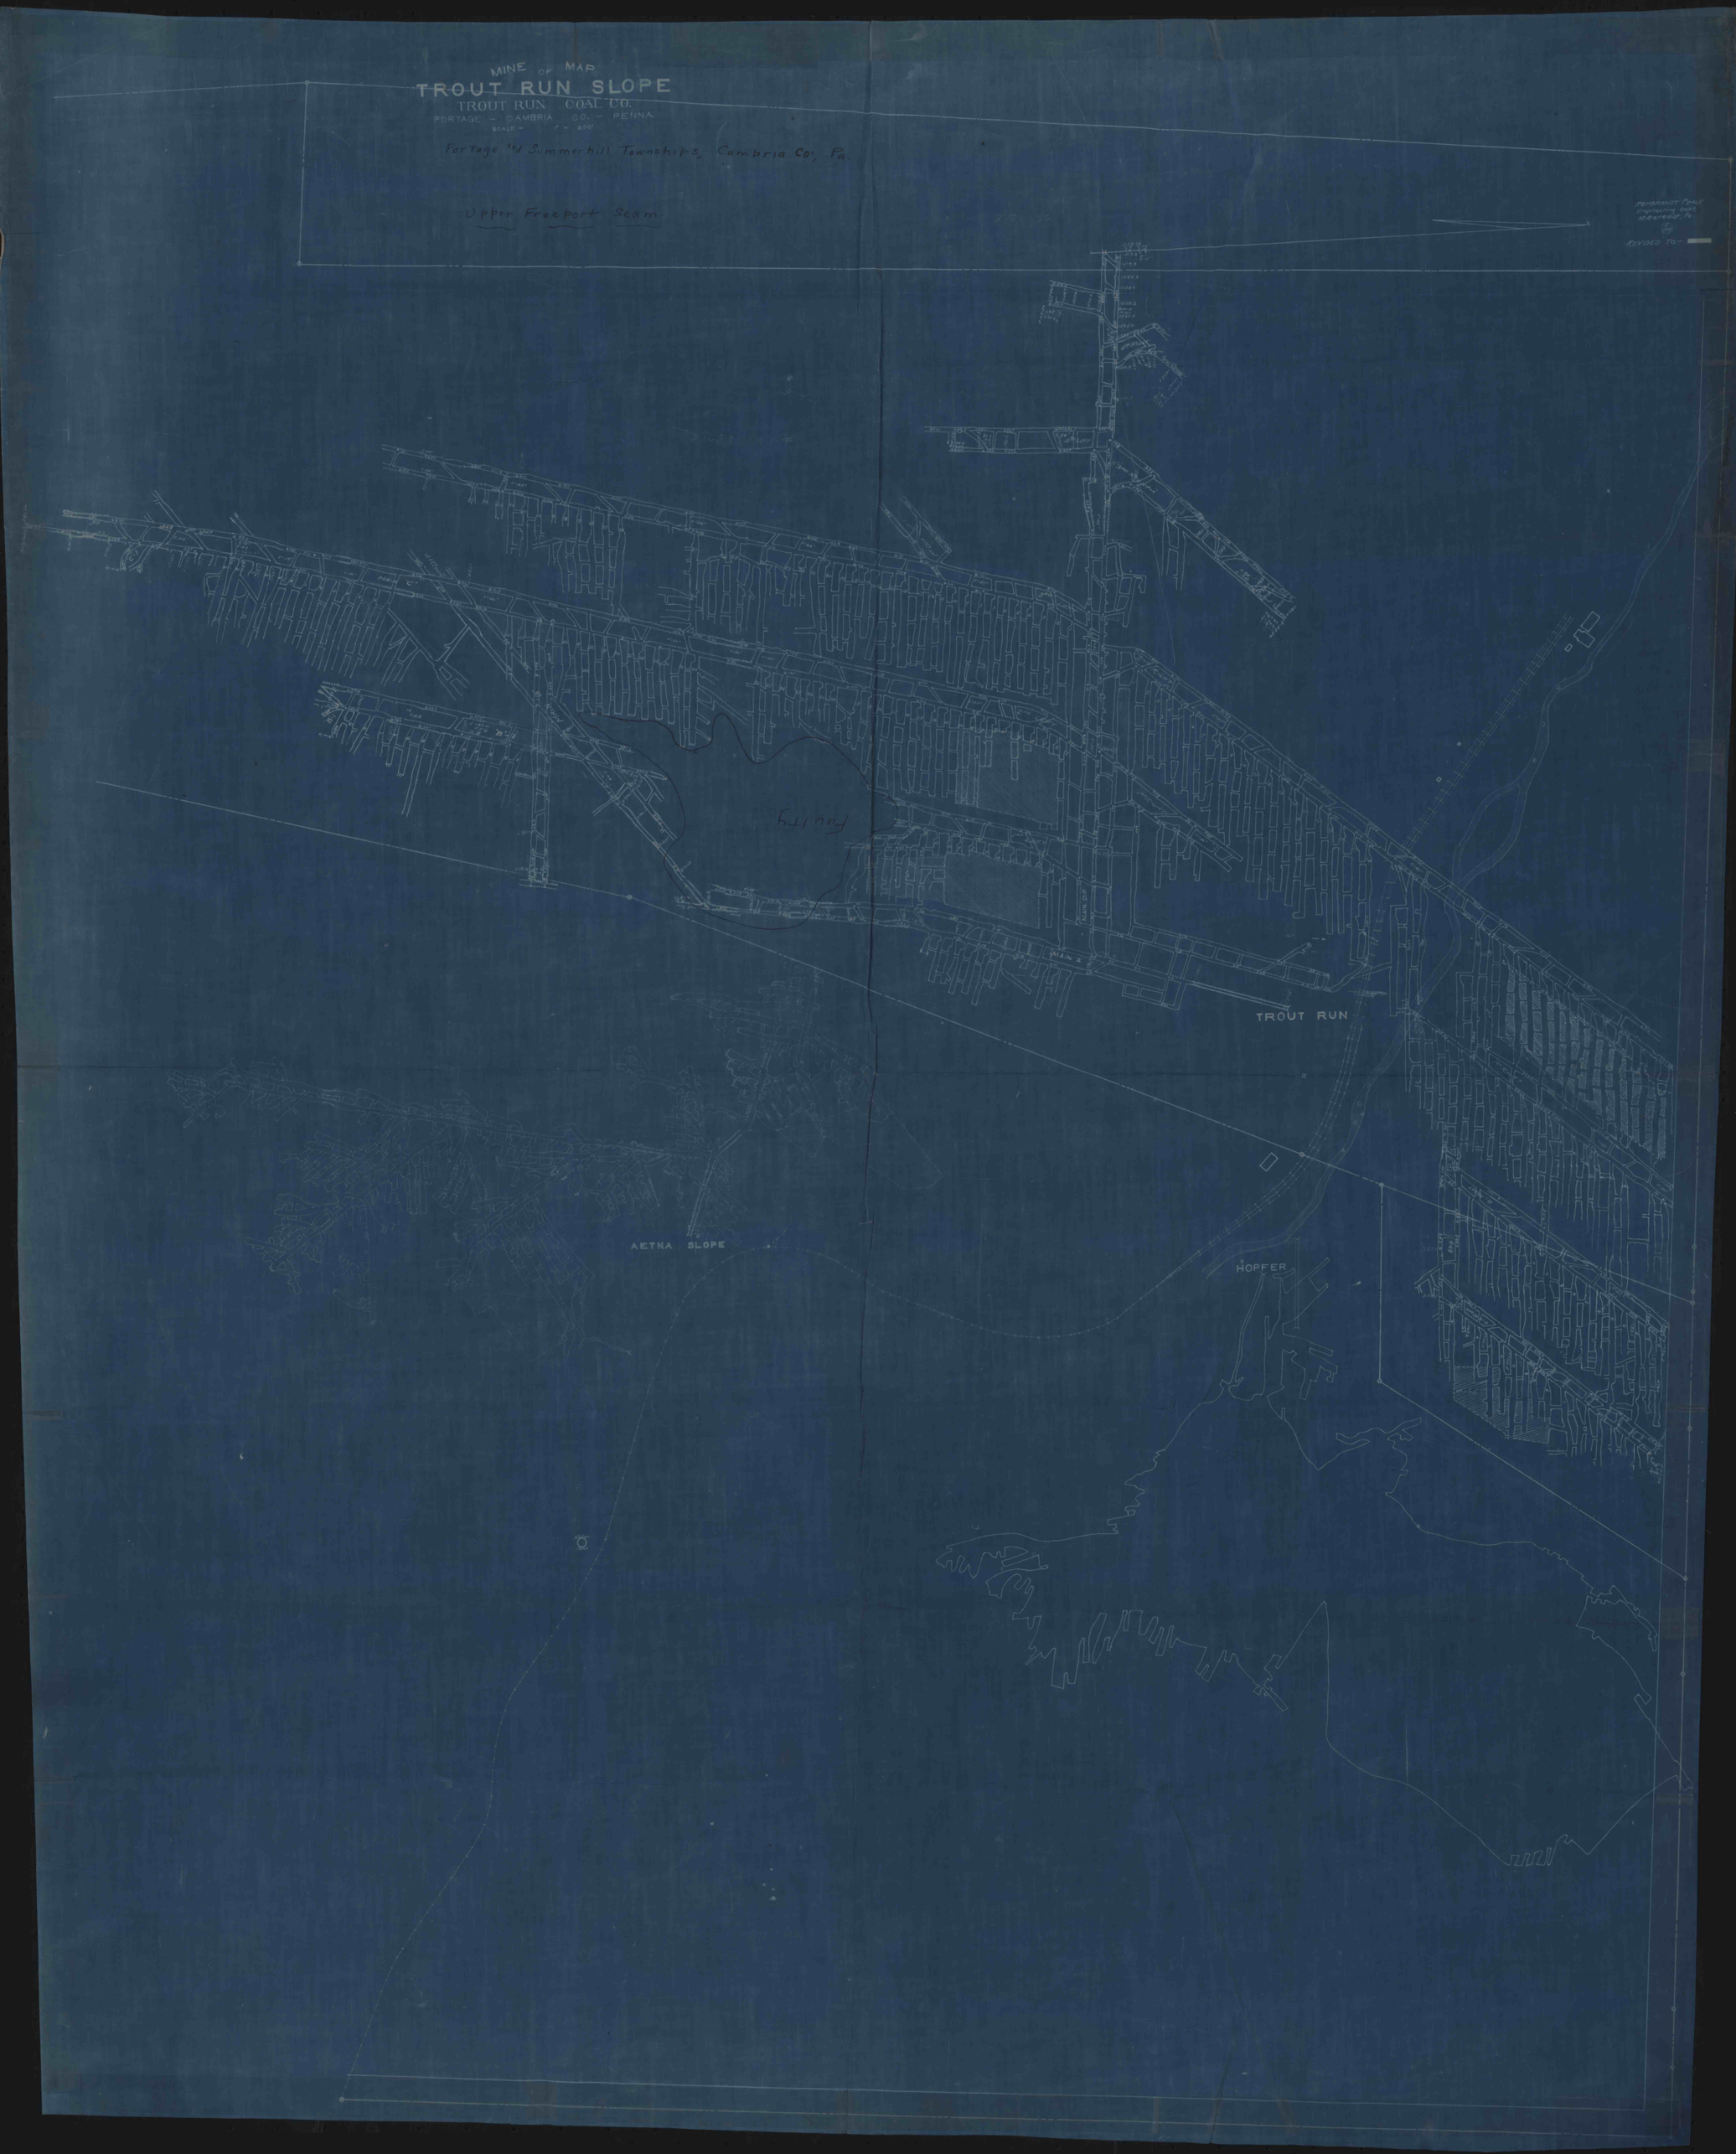
MINE OF MAP
TROUT RUN SLOPE
TROUT RUN COAL CO.
PORTAGE - CAMBRIA CO. - PENNA.
SCALE - 1" = 200'
Portage and Summerhill Townships, Cambria Co., Pa.
Upper Freeport Seam.
REMBRANDT PEALE
Engineering Dept.
St. Benedict, Pa.
REVISED TO -
Faulty
MAIN A
TROUT RUN
AETNA SLOPE
HOPFER