
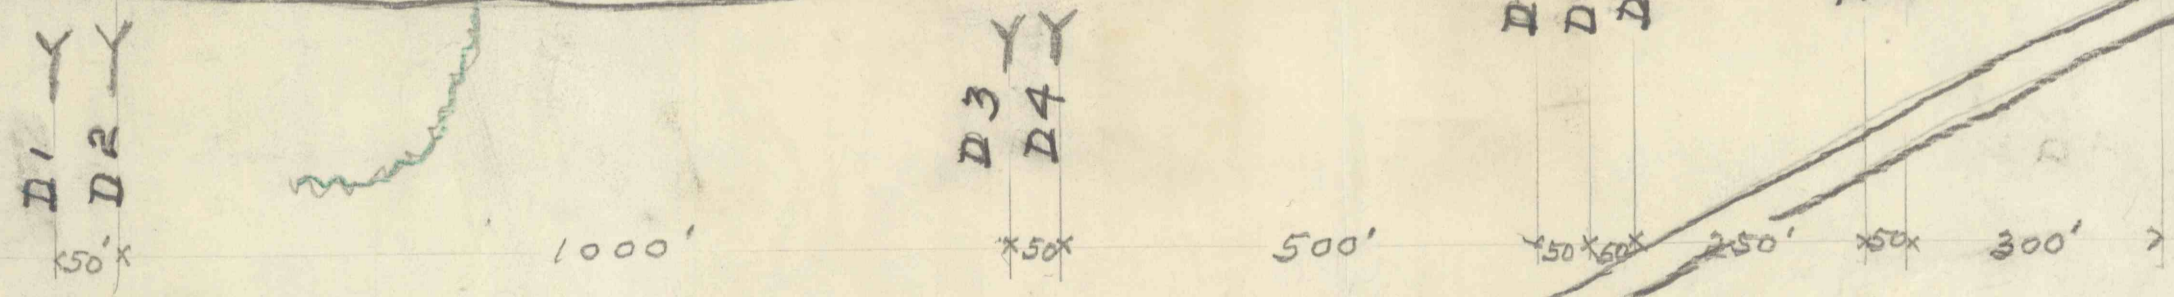
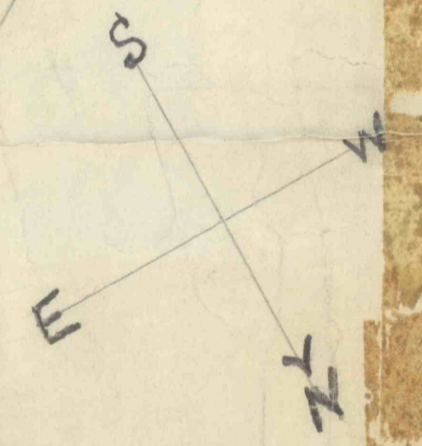
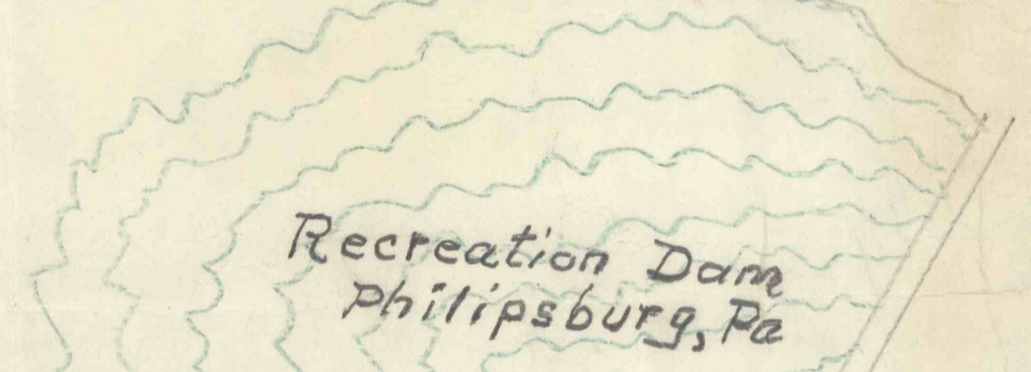


COLD STREAM RECREATION DAM WATERSHED
philipsburg, Pa.

Batchler #1
Under Construction

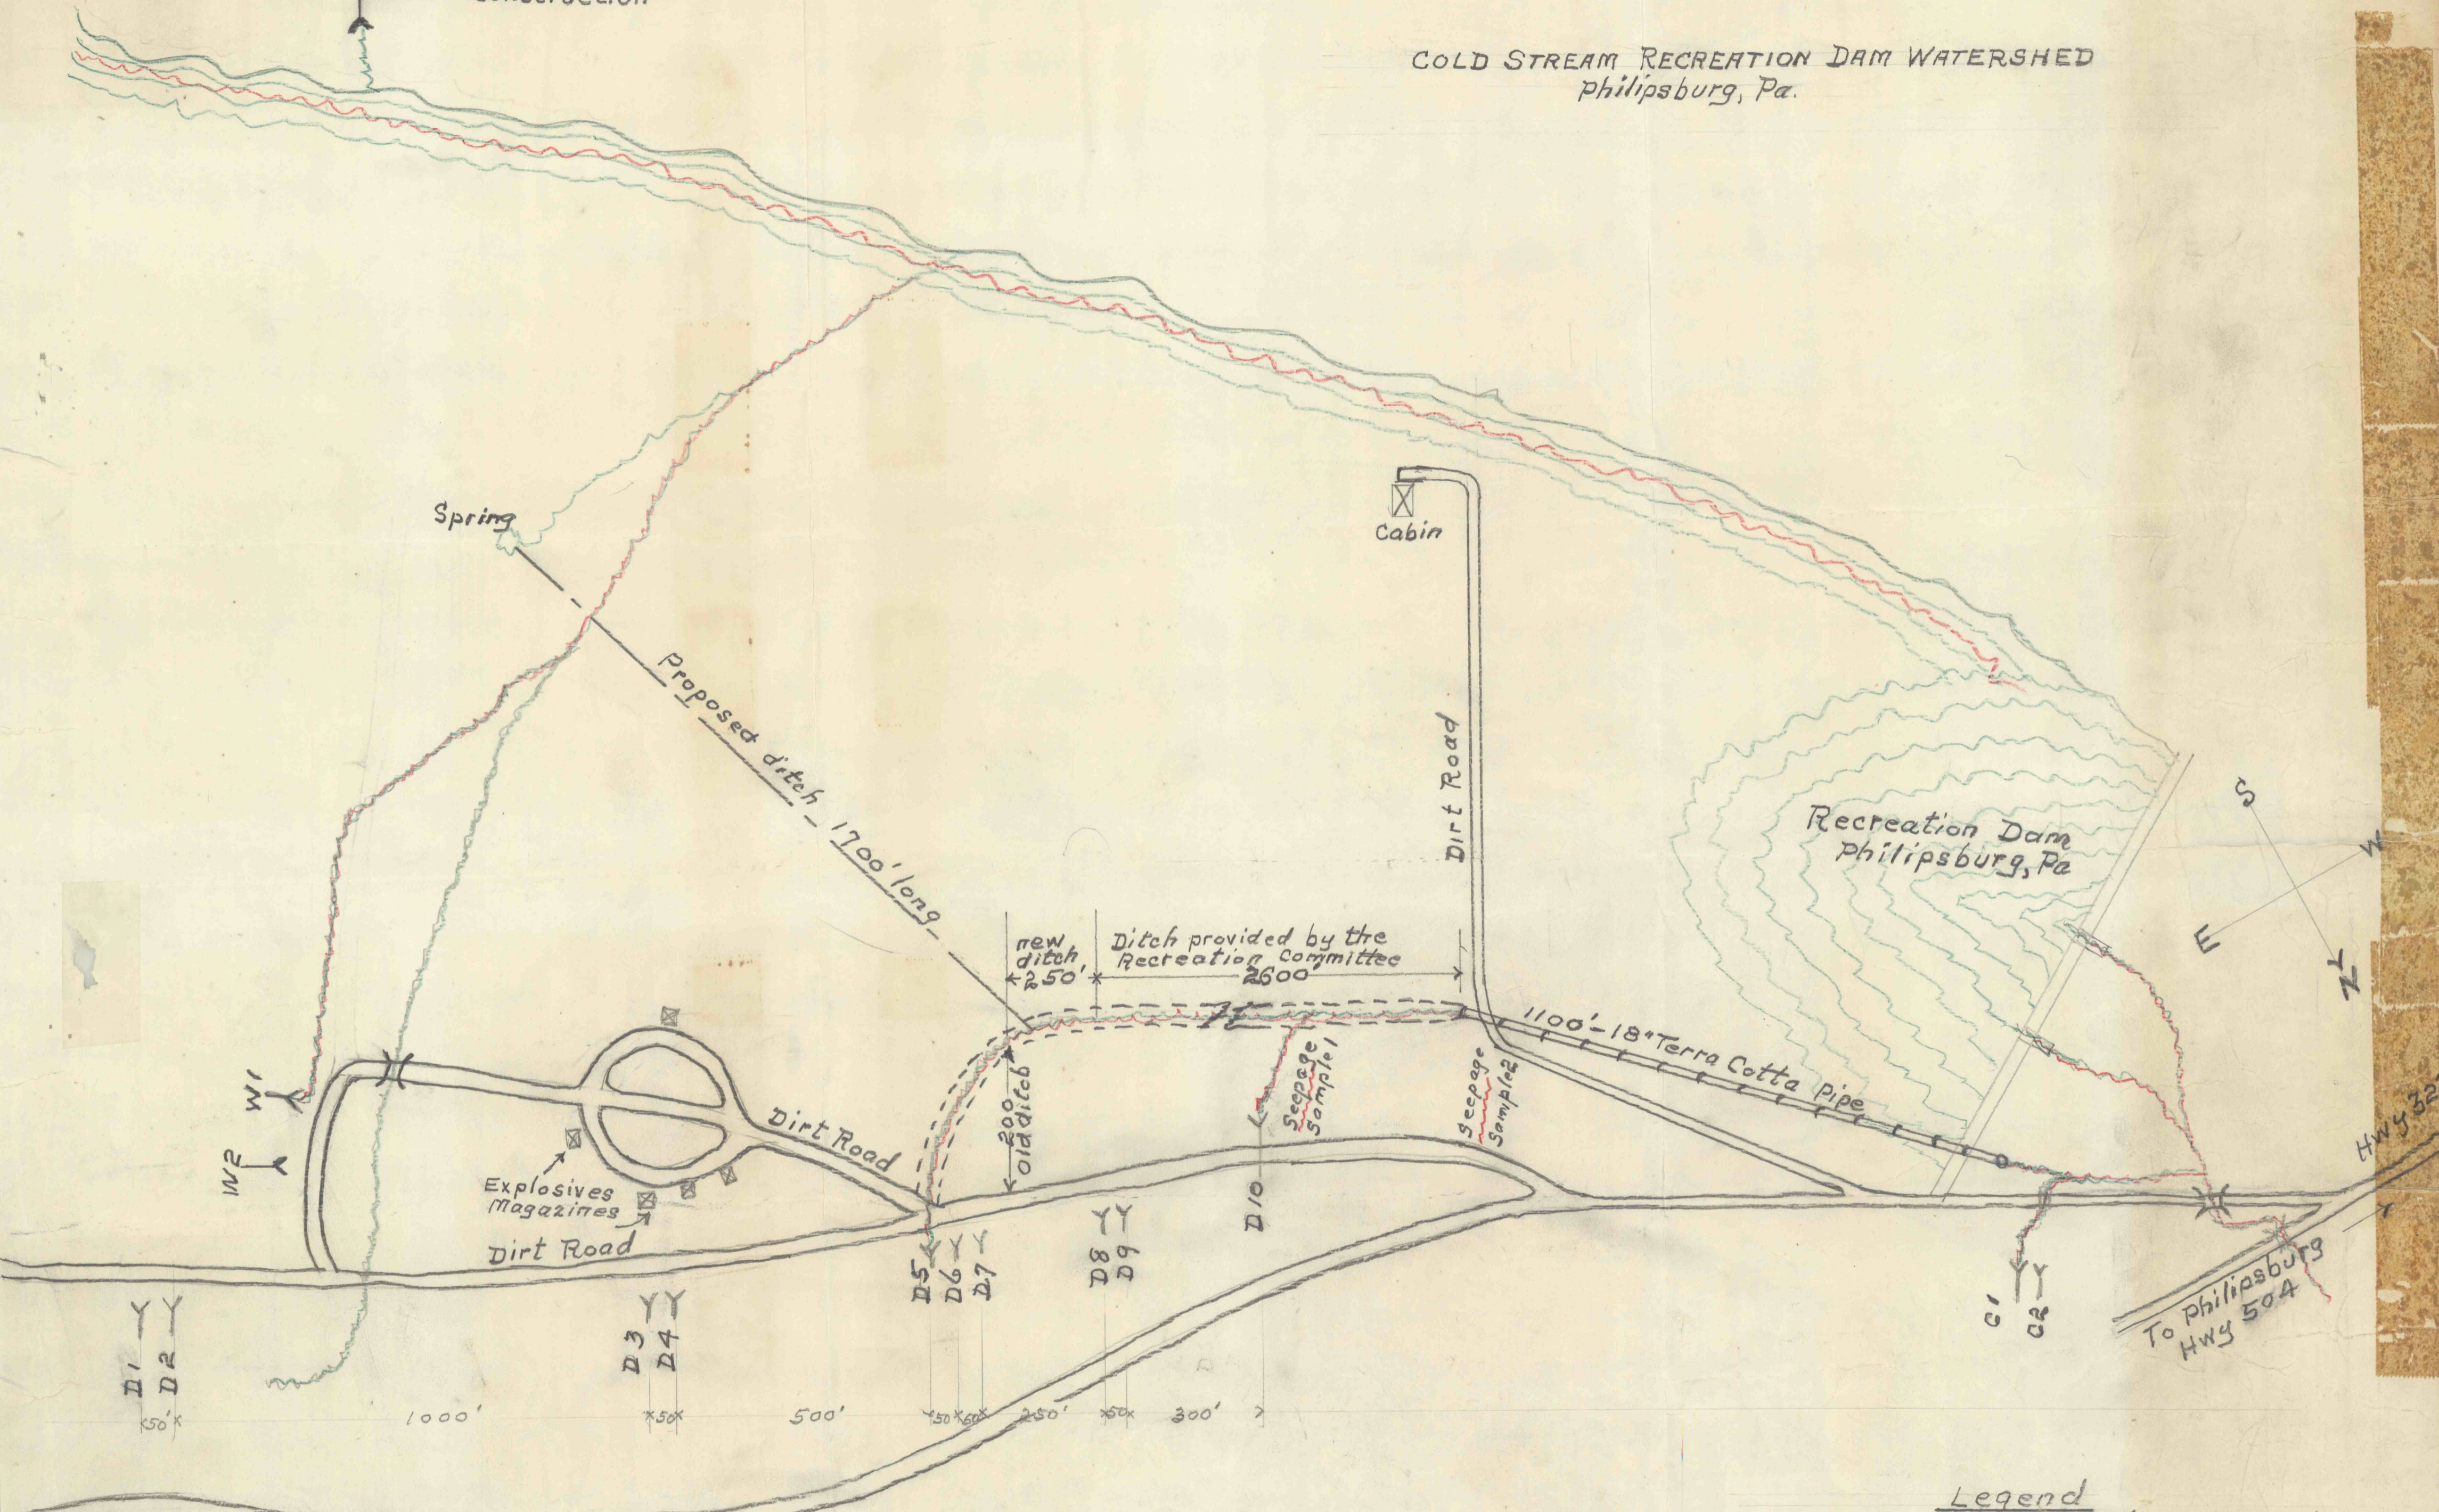

To State College Hwy 322

To philipsburg
Hwy 504

Water analyses attached

Legend
 C 1 & 2 Cold Steam seals
 D 1 to 10 Dumbleton seals
 W 1 & 2 Woodcock seals
 C 1 Wet
 D 5 & 10 Wet
 W 1 Wet
 June 12, 1952
 Scale 1" = 200'
 M. R. Evans, Div Engr.