




- MINE VENTILATION PLAN LEGEND:**
- MINE PERMIT/PROPERTY BOUNDARY
  - ABANDONED AREA TO BE VENTILATED
  - OUTCROP UNDER FREEPORT COAL SEAM
  - STRUCTURE CONTOUR ON LOWER FREEPORT COAL
  - PROPOSED 12 MO. PROJ. 6/15/97 - 6/15/98
  - INTAKE AIR
  - RETURN AIR
  - PERMANENT STOPPINGS
  - BELT CONVEYOR & AIR FLOW
  - ESCAPEWAY ON INTAKE AIR
  - ALTERNATE ESCAPEWAY
  - CHECK CURTAINS
  - DOUBLE DOOR FOR EQUIP. TRAVEL
  - SINGLE DOOR/MANWAY
  - OVERCASTS
  - REGU. LATORS
  - INTAKE SCREENS
  - VENTED BRATTICE-BLOCK REMOVED
  - INLET EVALUATION POINT
  - BLEEDER EVALUATION PT.
  - PROP. SEALS
  - PROP. PERMANENT STOPPING
  - PROP. EVALUATION POINT (INLET OR BLEEDER)
  - MAXIMUM POTENTIAL WATER LEVEL
  - IN ABANDONED SECTION-IN ACCESSIBLE FOR ACTUAL MEASUREMENT
  - NO OIL OR GAS WELLS ON MINING AREA LIMITS
  - CONSTRUCTED SEAL W/ IDENTIFICATION NO.
  - EVALUATION POINT
  - CAVED AREA
  - PILLARED AREA

TRENT COAL, INC. RICE #2 MINE, I.D. 36-83636  
 Map Showing Final Extent of Mine Workings  
 As Per Final Survey Conducted 5/19/98.  
 Temporary Seals To Be Constructed Across  
 Entries Until Such Time That Mine Is Re-opened  
 Or Permanent Closure Plan Is Implemented.

JUL 14 2008

SHEET 3

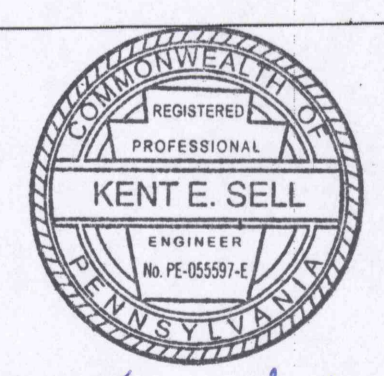

75.1200 / 75.372 MAP  
 EXHIBIT 19.5  
**TRENT COAL, INC.**  
 MINE NAME: RICE #2 MINE  
 MINE ADDRESS: R. D. 1, PORTAGE, PA.  
 MAILING ADDRESS: R. D. 1, FRIENDS, PA. 18541  
 MINE I. D.: 36-03636  
 DEP. PERMIT NO.: 118-41302  
 MINE LOCALITY: PORTAGE & SUMMERHILL TWP  
 CAMBRIA CO., PA.  
 COAL SEAM: LOWER FREEPORT  
 SCALE: 1" = 200'  
 DATE: JUL 14 2008

