

COMMON WEALTH OF PENNA. GAME LANDS NO. 26
SURFACE

SUMMERHILL TOWNSHIP
PORTAGE TOWNSHIP

AMS LAND CO.


LEONARD KALINOSKI

SURFACE MINED AREA

COONEY BROS COAL CO.
SMP 11900105 &
SMP 11693042

IE NO 1 12" SE 29.49' BE 2320
IE NO 2 6" SE 25.07' BE 2320

- MINE VENTILATION PLAN LEGEND:**
- MINE PERMIT/PROPERTY BOUNDARY
 - ABANDONED AREA TO BE VENTILATED
 - OUTCROP LOWER FREEPORT COAL SEAM
 - STRUCTURE CONTOUR ON LOWER FREEPORT COAL
 - PROPOSED 12 MO. PROJ. 6/15/98 - 6/15/98
 - INTAKE AIR
 - RETURN AIR
 - PERMANENT STOPPINGS
 - BELT CONVEYOR & AIR FLOW
 - ESCAPEWAY ON INTAKE AIR
 - ALTERNATE ESCAPEWAY
 - CHECK CURTAINS
 - DOUBLE DOOR FOR EQUIP. TRAVEL
 - SINGLE DOOR/MANWAY
 - OVERCASTS
 - REGULATORS
 - INTAKE BOREHOLE
 - VENTED BRATTICE-BLOCK REMOVED
 - INLET EVALUATION POINT
 - BLEEDER EVALUATION PT.
 - PROP. SEALS
 - PROP. PERMANENT STOPPING
 - PROP. EVALUATION POINT (INLET OR BLEEDER)
 - MAXIMUM POTENTIAL WATER LEVEL
 - IN ABANDONED SECTION-IN ACCESSIBLE FOR ACTUAL MEASUREMENT
 - NO OIL OR GAS WELLS ON MINING AREA LIMITS
 - CONSTRUCTED SEAL w/ IDENTIFICATION NO.
 - EVALUATION POINT
 - CAVED AREA
 - PILLARED AREA

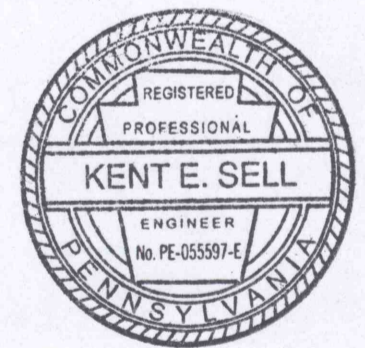

Kent E. Sell

TRENT COAL, INC.

MINE NAME: RICE #2 MINE
MINE ADDRESS: R.D. 1, PORTAGE, PA.
MAILING ADDRESS: R.D. 1, FRIEDENS, PA. 19541
MINE I.D.: 36-03636
DER. PERMIT NO.: 11841302
MINE LOCALITY: PORTAGE & SUMMERHILL TOWNSHIPS
CAMBERIA CO., PA.
COAL SEAM: LOWER FREEPORT
SCALE: 1" = 200'
DATE: JUL 14 2008

TRENT COAL, INC. RICE #2 MINE, I.D. 36-03636/
Map Showing Final Extent of Mine Workings
As Per Final Survey Conducted 5/19/08.
Temporary Seals To Be Constructed Across
Entries Until Such Time That Mine Is Re-opened
Or Permanent Closure Plan Is Implemented.

SHEET NO. 2

RECEIVED
JUL 17 2008

SHEET NO. 2

JUL 14 2008

RIGHT SIDE SHEET NO. 2
MATCH TO SHEET 4

MATCH LINE TO SHEET

MATCH TO TOP SHEET NO. 1