




MATCH LINE TO SHEET 2

MATCH LINE TO SHEET 3

TRENT COAL, INC. RICE #2 MINE, I.D. 36-03636
 Map Showing Final Extent of Mine Workings
 As Per Final Survey Conducted 5/19/98.
 Temporary Seals To Be Constructed Across
 Entries Until Such Time That Mine Is Re-opened
 Or Permanent Closure Plan Is Implemented.

RECEIVED
 JUL 17 2008
 California District Office

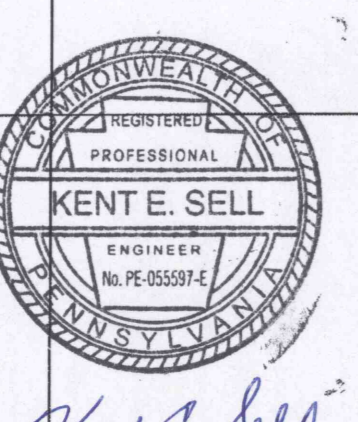

- MINE VENTILATION PLAN LEGEND:**
- MINE PERMIT/PROPERTY BOUNDARY
 - - - ABANDONED AREA-TO BE VENTILATED
 - OUTCROP LOWER FREEPORT COAL SEAM
 - PROPOSED 12 MO. PROJ. 6/15/97 - 6/15/98
 - INTAKE AIR
 - RETURN AIR
 - PERMANENT STOPPINGS
 - BELT CONVEYOR & AIR FLOW
 - ESCAPEWAY OR INTAKE AIR
 - ALTERNATE ESCAPEWAY
 - CHECK CHAINS
 - DOUBLE DOOR FOR EQUIP TRAVEL
 - SINGLE DOOR/MANWAY
 - OVERCASTS
 - REGULATORS
 - INTAKE BOREHOLE
 - VENTED BRATICE-BLOCK REMOVED
 - INLET EVALUATION POINT
 - BLEEDER EVALUATION PT.
 - PROP. SEALS
 - PROP. PERMANENT STOPPING
 - PROP. EVALUATION POINT (INLET OR BLEEDER)
 - MAXIMUM POTENTIAL WATER LEVEL
 - IN ABANDONED SECTION-IN ACCESSIBLE FOR ACTUAL MEASUREMENT
 - NO OIL OR GAS WELLS ON MINING AREA LIMITS
 - CONSTRUCTED SEAL W/ IDENTIFICATION NO.
 - EVALUATION POINT
 - CAVEED AREA
 - DILLARED AREA

75.1200 / 75.372 MAP
 EXHIBIT 19.5
TRENT COAL, INC.
 MINE NAME: RICE #2 MINE
 MINE ADDRESS: R.D. 1, PORTAGE, PA.
 MAILING ADDRESS: R.D. 1, FRIEDENS, PA. 15541
 MINE I.D.: 36-03636
 DES. PERMIT NO.: 118-4302
 MINE LOCALITY: PORTAGE & SUMMERHILL TOWNSHIPS, CAMBRIA CO., PA.
 COAL SEAM: LOWER FREEPORT
 SCALE: 1"=200'
 DATE: JUL 14 2008

SHEET 4