
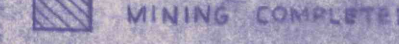







**LEGEND**

-  SUPPORT AREA
-  MINING COMPLETED
-  OLD VICTOR #44 MINE WORKINGS
-  CONTEMPLATED MINING 7-1-70 TO 12-31-73
-  PROTECTED STRUCTURE
-  MINE WORK TO DEC. 6/1970 MLE
-  REVISIONS

MANOR MINING & CONTRACTING CO. BIGLER, PA.			
SCALE	1" = 200'	REVISIONS	BY DATE
DATE	4/11/60	6/16/60	
DATE	12-15-64		
APPROVED			
TITLE MAP OF MANOR AND #44 MINE SHADES MINE CO. CARFIELD CO.			3171