

MATCH TO SHEET 4

MATCH TO SHEET 5

MATCH TO SHEET 8




ROXCOAL, INC.  
 BARBARA #2 MINE  
 LOWER KITTANNING SEAM  
 M.A.P. NO. 56851303  
 MINING PERIOD 5-1-01 to 11-1-01  
 SURVEY DATE: 1-12-01  
 FINAL MINE MAP  
 STONYCREEK & BROTHERSVALLEY TOWNSHIPS  
 SOMERSET COUNTY, PA SCALE: 1"=200'

SUBSIDENCE LEGEND

SUBSIDENCE CONTROL BLOCK 50% MINING AREA	
DWELLINGS	
OTHER BUILDINGS	
CONTEMPLATED MINING	
PREVIOUS SIX MONTH'S MINING	
SUBSIDENCE CONTROL PLAN BOUNDARY	
PROPERTY LINE	
NO MINING AREA (RESERVATION)	

ROXCOAL, INC.  
 P.O. BOX 149  
 FRIEDENS, PA 15541  
 (814) 445-3876

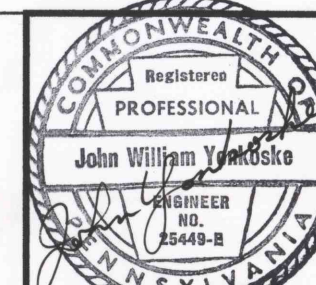

SHEET 6

5-24-01