

Glenn Stroupe


N89°30'E

1435.5'

Dist 4

Emery Brothers
Coal Mine
Pine Creek Twp. Jeff. Co. Pa.
scale 200' = 1" = 1/2"

Charles Zimmerman
N0°30'W
1714.3'

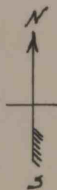


Crop Line

Solid coal

1714.3'

Paul Swartz

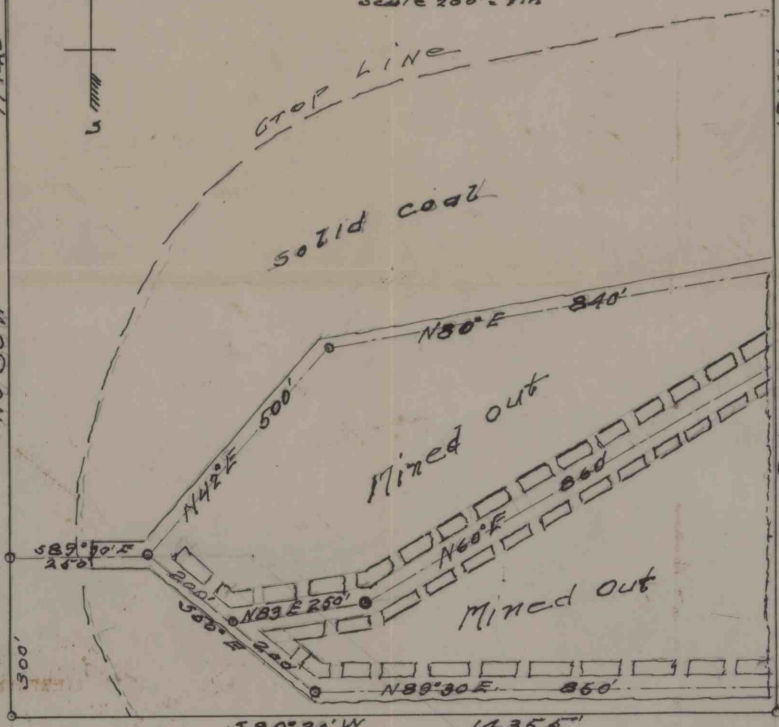

G.O. Schuckers