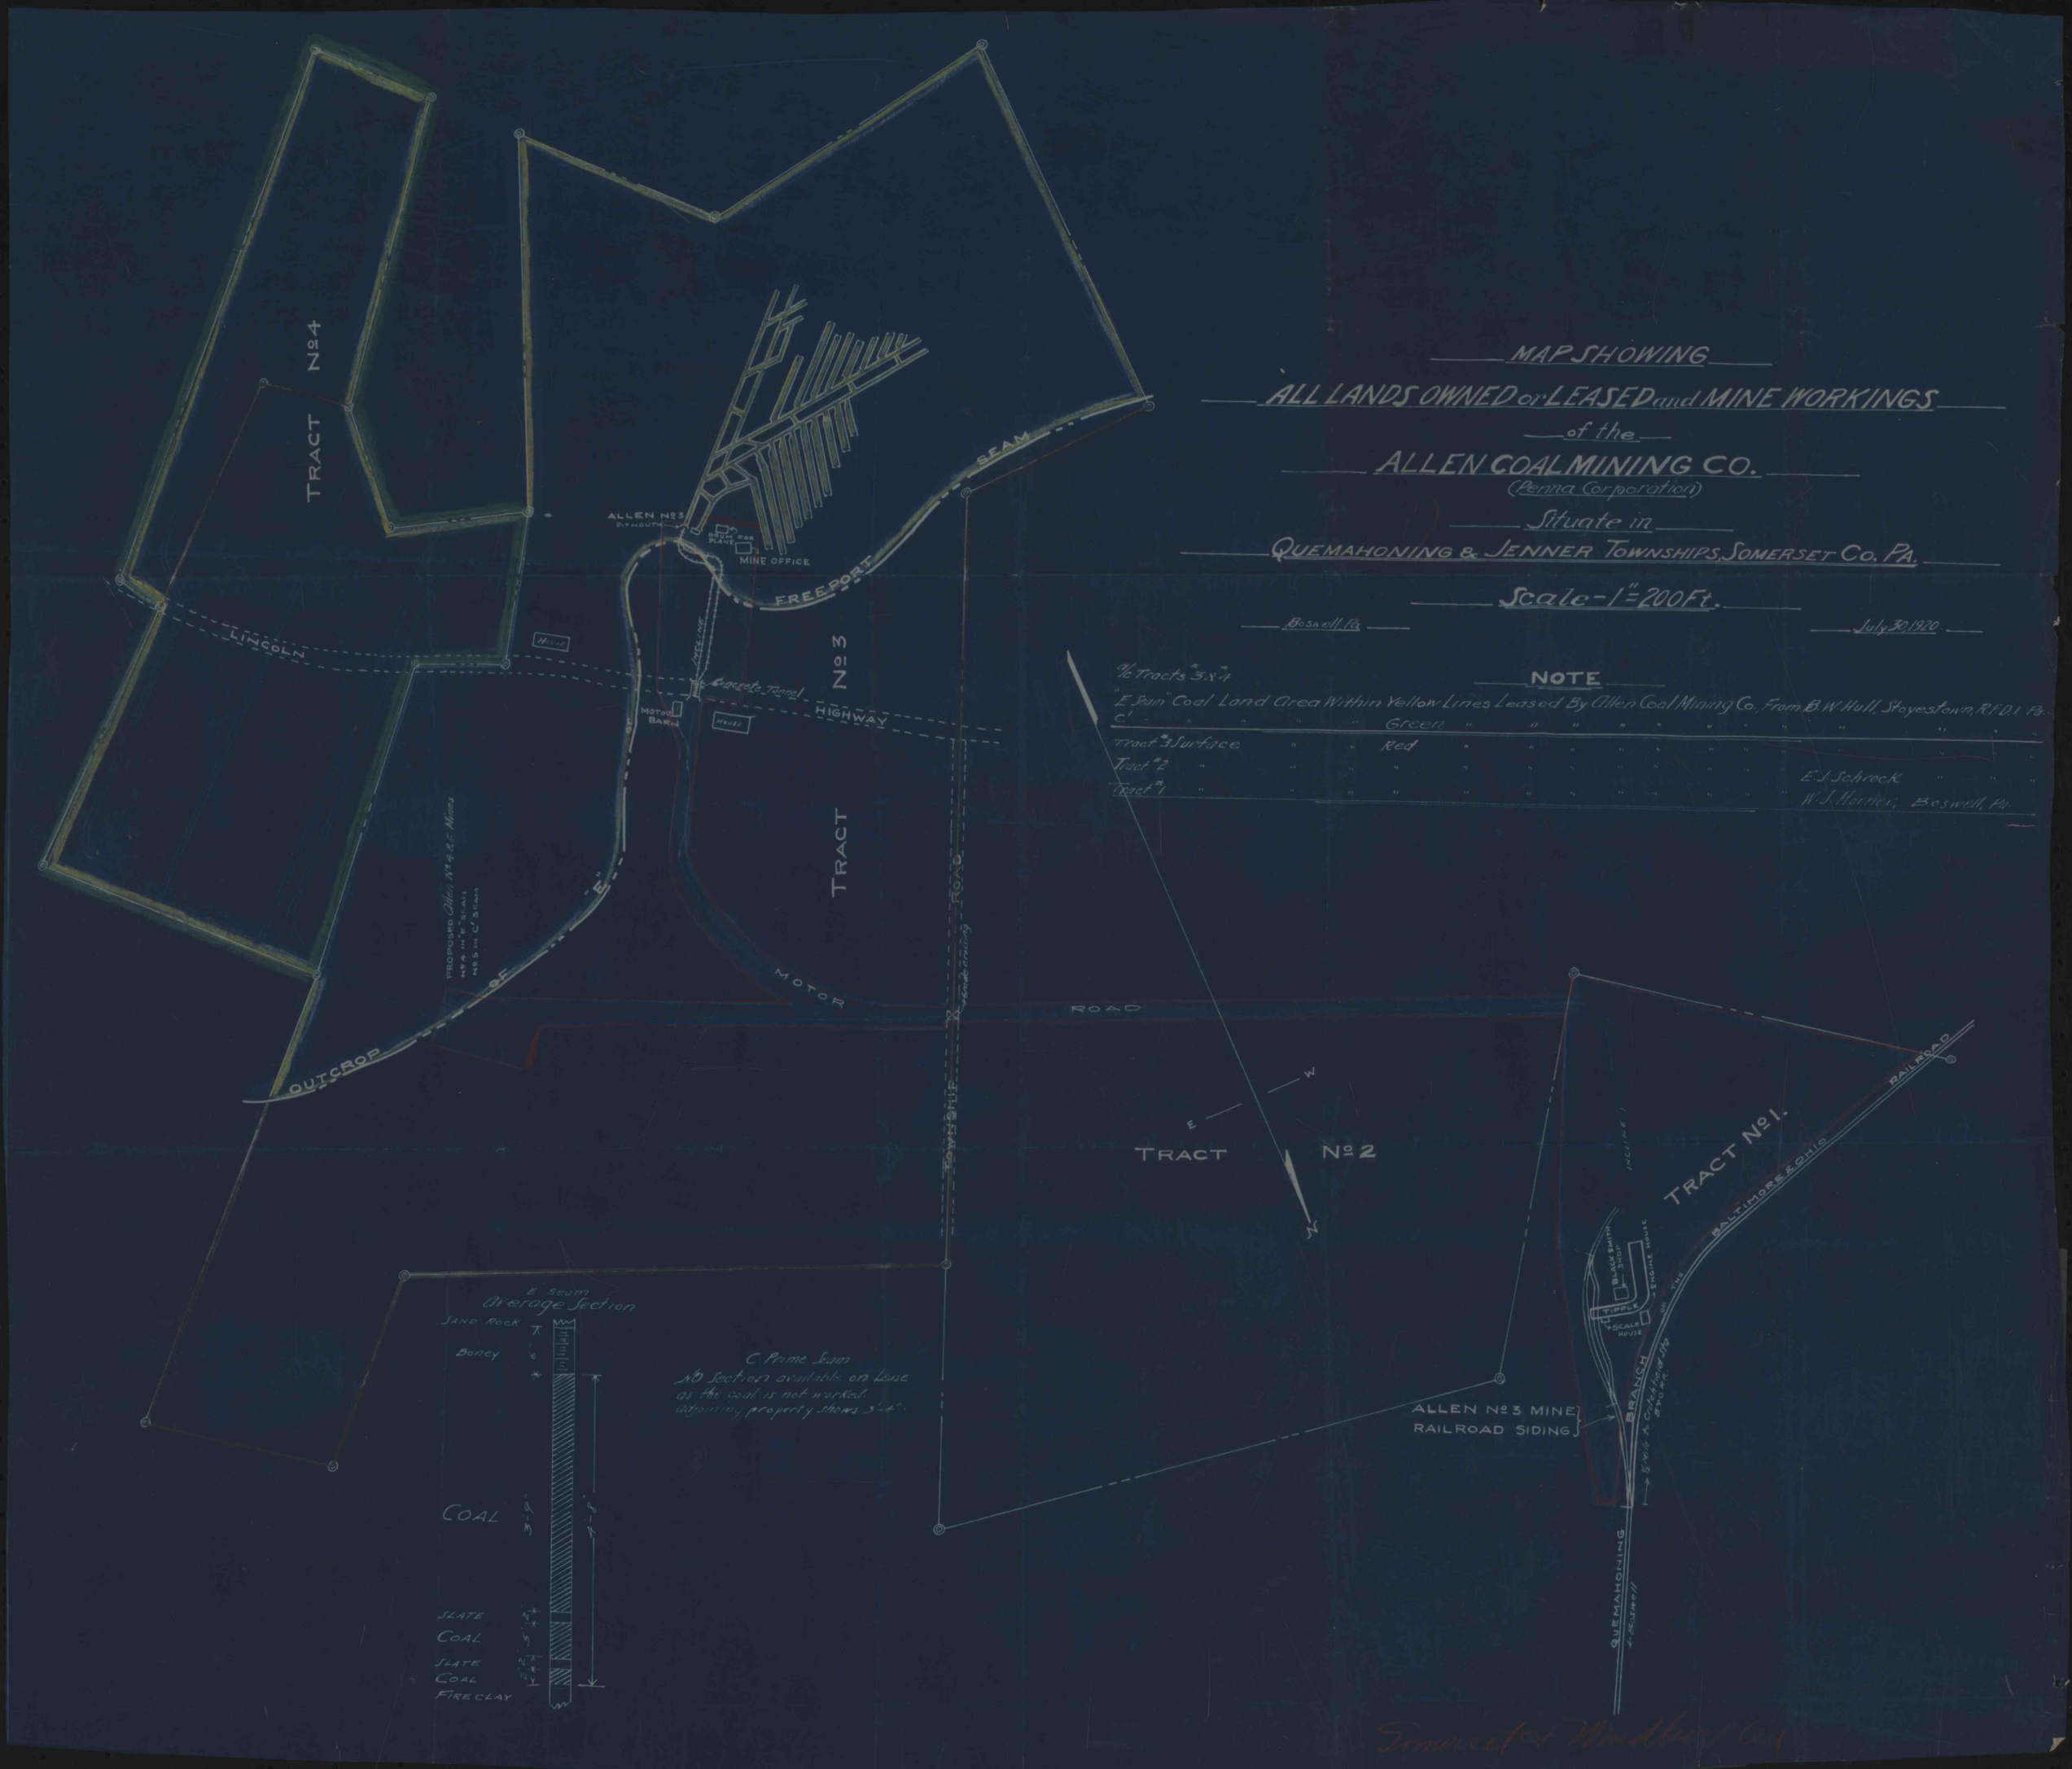
MAP SHOWING
ALL LANDS OWNED or LEASED and MINE WORKINGS
of the
ALLEN COAL MINING CO.
(Penna Corporation)
Situate in
QUEMAHONING & JENNER TOWNSHIPS, SOMERSET CO. PA.
Scale-1"=200 Ft.
Boswell, Pa.
July 30, 1920.
NOTE
a/c Tracts #3 & #4
"E Seam" Coal Land Area Within Yellow Lines Leased By Allen Coal Mining Co., From B. W. Hull, Stoyestown, R.F.D.1, Pa.
C' " " " " " Green " " " " " " " " " " " "
Tract #3 Surface " " Red " " " " " " " " " " "
Tract #2 " " " " " " " " " " " " E. J. Schrock " " "
Tract #1 " " " " " " " " " " " " W. J. Horner, Boswell, Pa.
TRACT No 4
TRACT No 3
TRACT No 2
TRACT No 1.
ALLEN No 3 PITMOUTH
DRUM FOR PLANE
MINE OFFICE
FREEPORT SEAM
LINCOLN HIGHWAY
Concrete Tunnel
MOTOR BARN
HOUSE
INCLINE
PROPOSED Allen No 4 & 5 Mines
No 4 in "E" SEAM
No 5 in "C" SEAM
OUTCROP OF "E"
MOTOR ROAD
TOWNSHIP ROAD
Grade Crossing
E
W
N
E Seam
Average Section
SAND ROCK
Boney
COAL
SLATE
COAL
SLATE
COAL
FIRECLAY
C Prime Seam
NO Section available on Lease as the coal is not worked. adjoining property shows 3'-4".
ALLEN No 3 MINE
RAILROAD SIDING
BLACK SMITH SHOP
ENGINE HOUSE
TIPPLE
SCALE HOUSE
INCLINE
BRANCH OF THE BALTIMORE & OHIO RAILROAD
QUEMAHONING
Boswell
Somerset & Windber Co.