


Enterprise Coal Co.
Enterprise
Washington Co. District 26
1956 Annual

WASHINGTON COUNTY HOME FARM

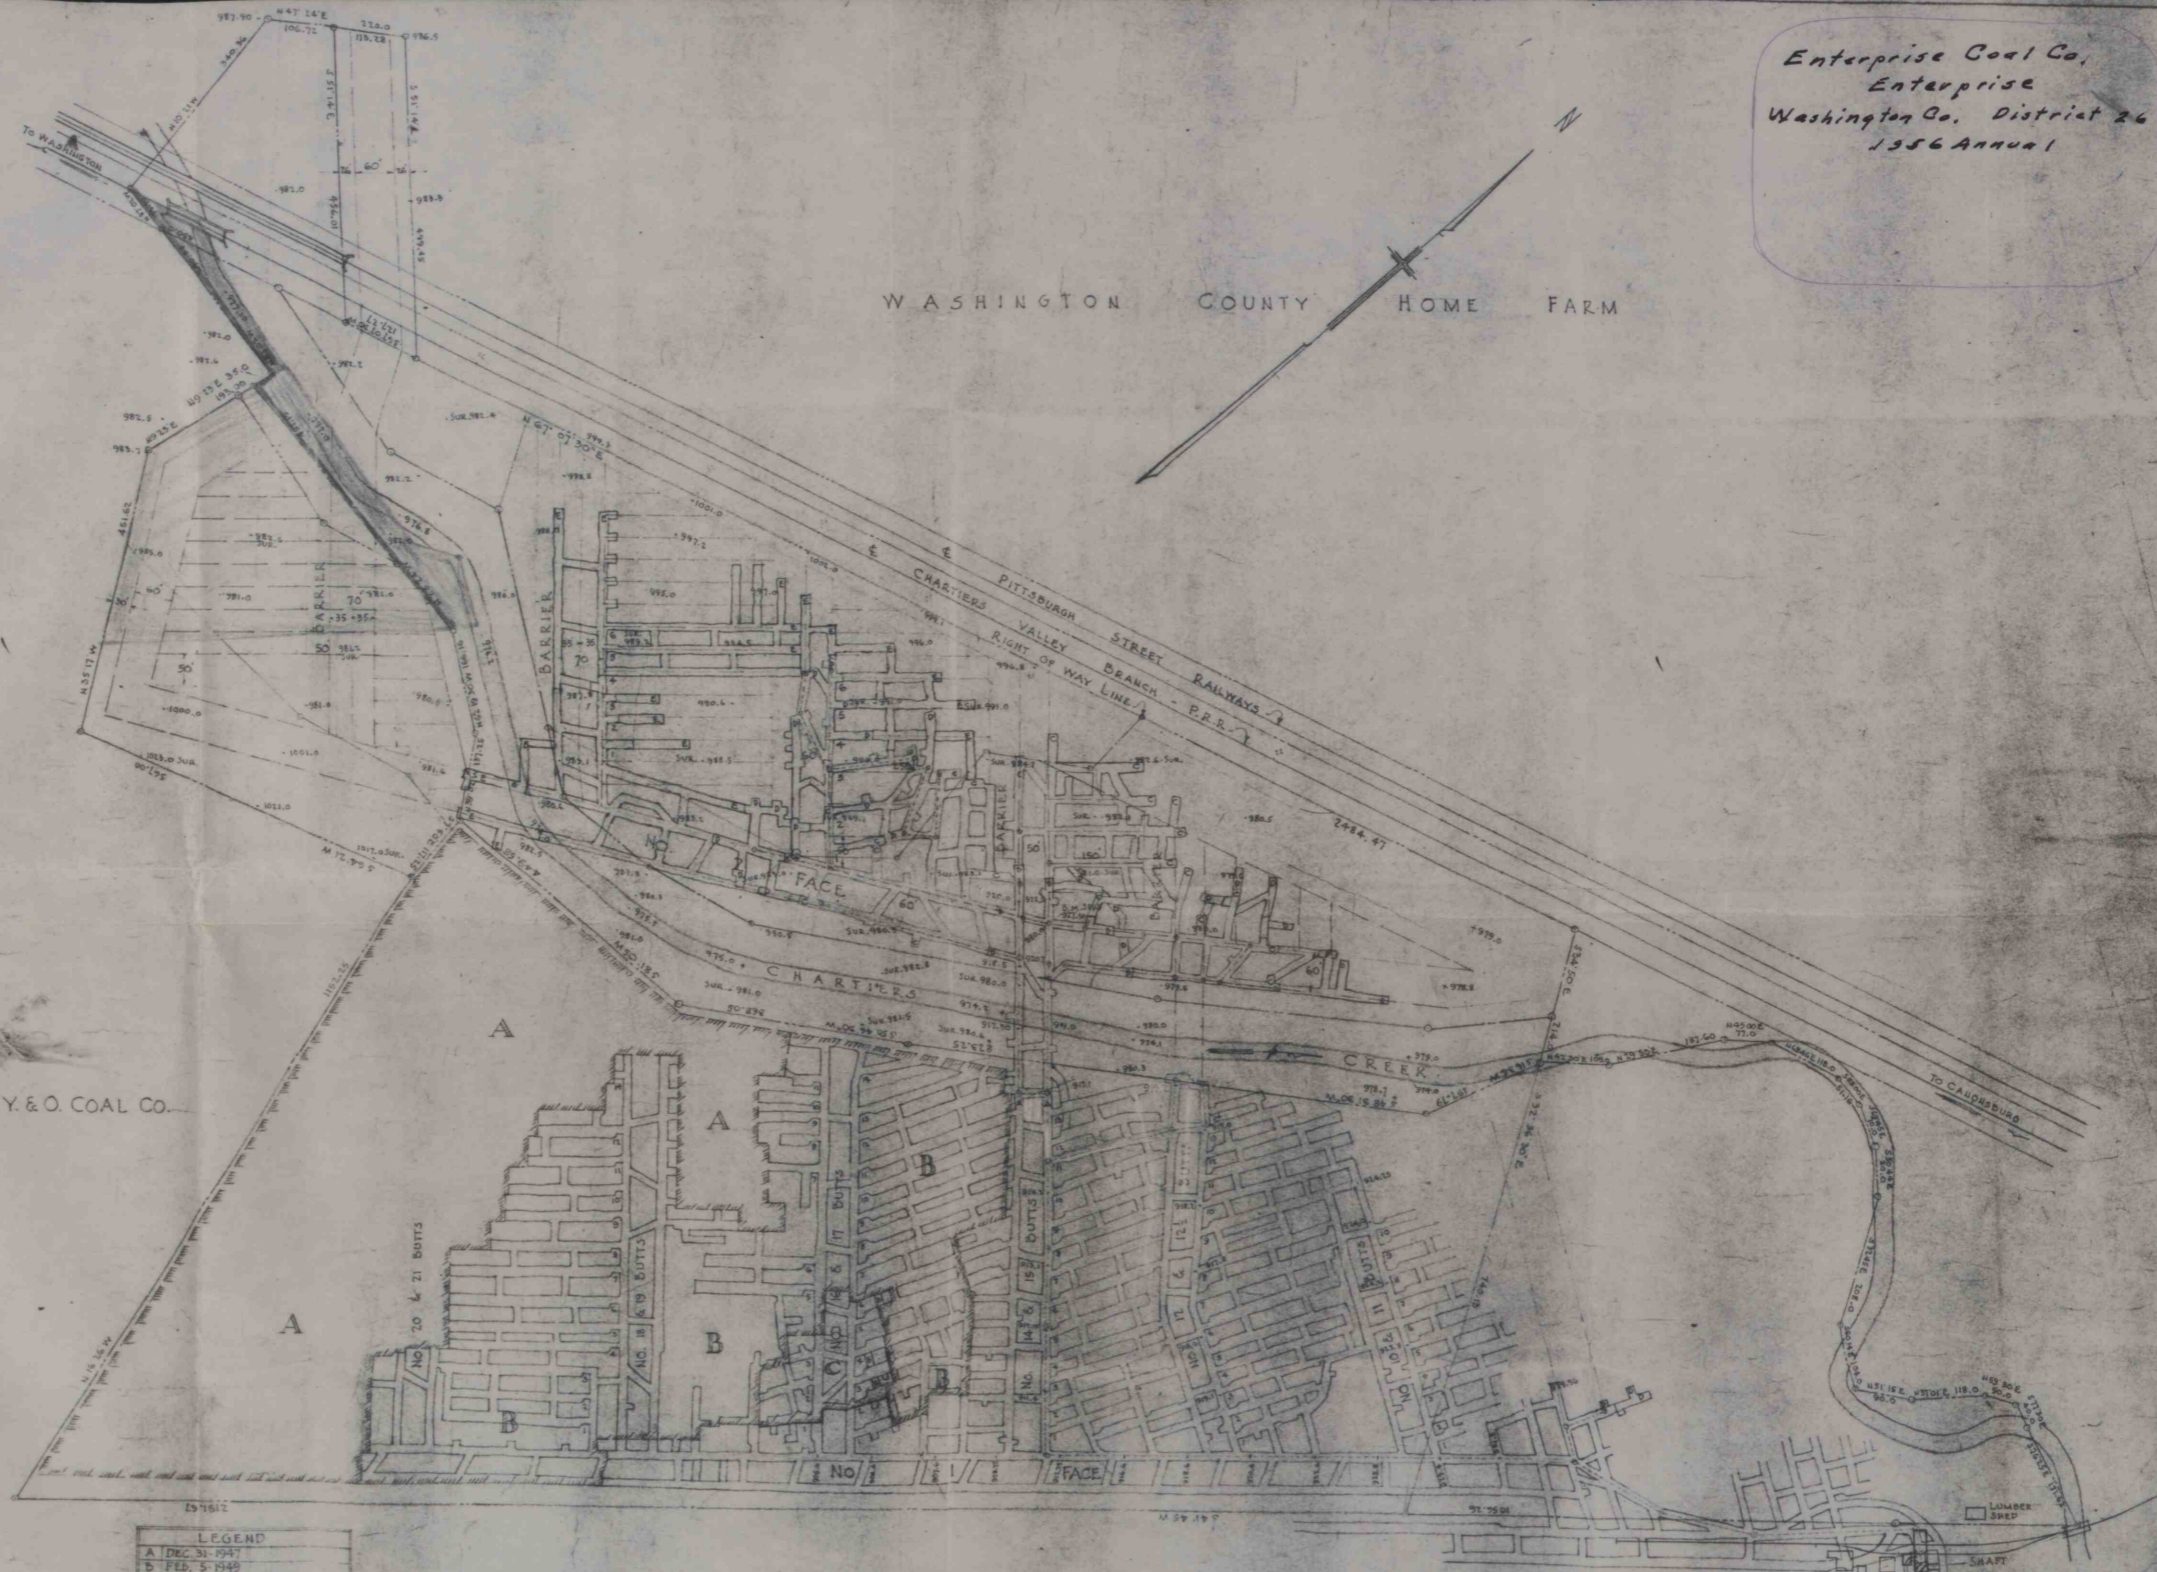

MINED OUT - Y. & O. COAL CO.

MINED OUT - Y. & O. COAL CO.

Mine Insp. Dr-26
Oil 497 905 " 3

LEGEND

A	DEC. 31. 1947
B	FEB. 5. 1949
C	JAN. 1. 1950
D	DEC. 5. 1950
E	FEB. 15. 1952

MAP OF
ENTERPRISE MINE
SPRINGER COAL CO.
CHARTIERS & SOUTH STRABANE TOWNSHIPS - WASH. CO. PA.
SCALE 1"=100' FEB. 1-1949
H. P. TAYLOR - P. R. E.

NOTE: THIS MAP MADE IN PART FROM SURVEY AND PREVIOUS MAPS

