



MAIN MINE FAN DATA:
 Manufacturer: Jeffery
 Model Number: 12L10-60
 Fan type: Axiflex
 Size: 60"
 Horsepower: 100
 RPM's: 1380
 Operating Pressure: 1.5"

SCHROCK No. 2
 (Abandoned) L.K.

SCHROCK No. 4
 (Abandoned) L.K.

FINAL MINE MAP

LEGEND

<p>PERMIT AREA</p> <p>UNDERGROUND WORKINGS</p> <p>TOWNSHIP BOUNDARY</p> <p>COUNTY BOUNDARY</p> <p>TEST BOREHOLE</p> <p>CROP LINES</p> <p>COAL CONTOURS</p> <p>SURFACE WORKINGS</p> <p>MINE OPENINGS, Not Sealed</p> <p>MINE OPENINGS, Sealed</p> <p>PROPERTY LINES</p> <p>PRE 1966 DWELLINGS</p>	<p>POST 1966 DWELLINGS</p> <p>CEMETERIES</p> <p>STRUCTURES</p> <p>MAJOR ELECTRIC LINES</p> <p>PIPELINES</p> <p>GAS WELLS</p> <p>WATER WELLS</p> <p>STREAMS</p> <p>LAKES or PONDS</p> <p>SPRING</p> <p>WATER TREATMENT FACILITIES</p> <p>CONTIGUOUS PROPERTY</p>
--	---

LEGEND cont.

WATER

6 MONTH PROJECTIONS

SUPPORT AREA

CONTEMPLATED MINING

COMPLETED MINING

SURVEY STATION

GAS WELL BARRIER

(No Mining Within Barrier Unless Approved)


COMMONWEALTH OF PENNSYLVANIA

REGISTERED PROFESSIONAL ENGINEER

JOSEPH P. KALYNCHUK

ENGINEER IN CHARGE

5-4-93

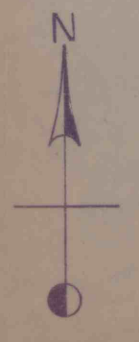

DOVERSPIKE BROS. COAL CO.

SUGARCAMP No. 2 MINE

SCALE: 1"=200'

DATE:

<p>INTAKE AIR</p> <p>RETURN AIR</p> <p>PRIMARY ESCAPEWAY</p> <p>SECONDARY ESCAPEWAY</p> <p>BELT LINE</p> <p>B-E POINTS (Approved)</p> <p>B-E POINTS (Proposed)</p> <p>STOPPING</p>	<p>STOPPING W/ DOOR</p> <p>CHECK CURTAIN</p> <p>REGULATOR</p> <p>DOUBLE DOORS(Equip. doors)</p> <p>OVERCAST</p>
--	---

Survey is closed loop, Accuracy is 1:10000
 Individuals responsible for information:
 Mark Penny, Engineer & Larry Smith, Superintendent

Stanford

PORTER TWP., JEFFERSON CO.

Doverpike Bros. Coal Co.

R.D. 4 Box 271, Panzostown, Pa. 15787

SUGARCAMP NO. 2

SHEET No. 2 of 16 SCALE 1"=200'

EXHIBIT "B"