
 PORTER TWP., JEFFERSON CO.
Doverspike Bros. Coal Co.
 P.O. Box 871, Punxsutawney, Pa. 15787
SUGARCAMP NO. 2
 SHEET No. 3 of 16 SCALE 1"=200'
EXHIBIT "B"

LEGEND


PERMIT AREA	POST 1966 DWELLINGS	10
UNDERGROUND WORKINGS	CEMETERIES	11
TOWNSHIP BOUNDARY	STRUCTURES	12
COUNTY BOUNDARY	MAJOR ELECTRIC LINES	13
TEST BOREHOLE	PIPELINES	14
CROP LINES	GAS WELLS	15
COAL CONTOURS	WATER WELLS	16
SURFACE WORKINGS	STREAMS	17
MINE OPENINGS, Not Sealed	LAKES or PONDS	18
MINE OPENINGS, Sealed	SPRING	19
PROPERTY LINES	WATER TREATMENT FACILITIES	20
PRE 1966 DWELLINGS	CONTIGUOUS PROPERTY	21

LEGEND cont.

WATER	6 MONTH PROJECTIONS
SUPPORT AREA	CONTEMPLATED MINING
COMPLETED MINING	COMPLETED MINING
SURVEY STATION	GAS WELL BARRIER

(No Mining Within Barrier Unless Approved)


 Joseph P. Kalyghur
 5-4-93
 SIGNATURE

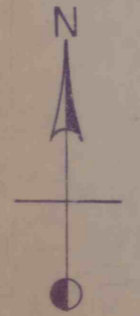

DOVERSPIKE BROS. COAL CO.
 SUGARCAMP No. 2 MINE SCALE: 1"=200'

DATE: _____	SCALE: 1"=200'
→ INTAKE AIR	⊞ STOPPING W/ DOOR
← RETURN AIR	⊞ CHECK CURTAIN
→ PRIMARY ESCAPEWAY	⊞ REGULATOR
→ SECONDARY ESCAPEWAY	⊞ DOUBLE DOORS (Equip. doors)
→ BELT LINE	⊞ OVERCAST
△ B-E POINTS (Approved)	
△ B-E POINTS (Proposed)	
— STOPPING	

Survey is closed loop, Accuracy is 1:10000
 Individuals responsible for information:
 Mark Penny, Engineer & Larry Smith, Superintendent