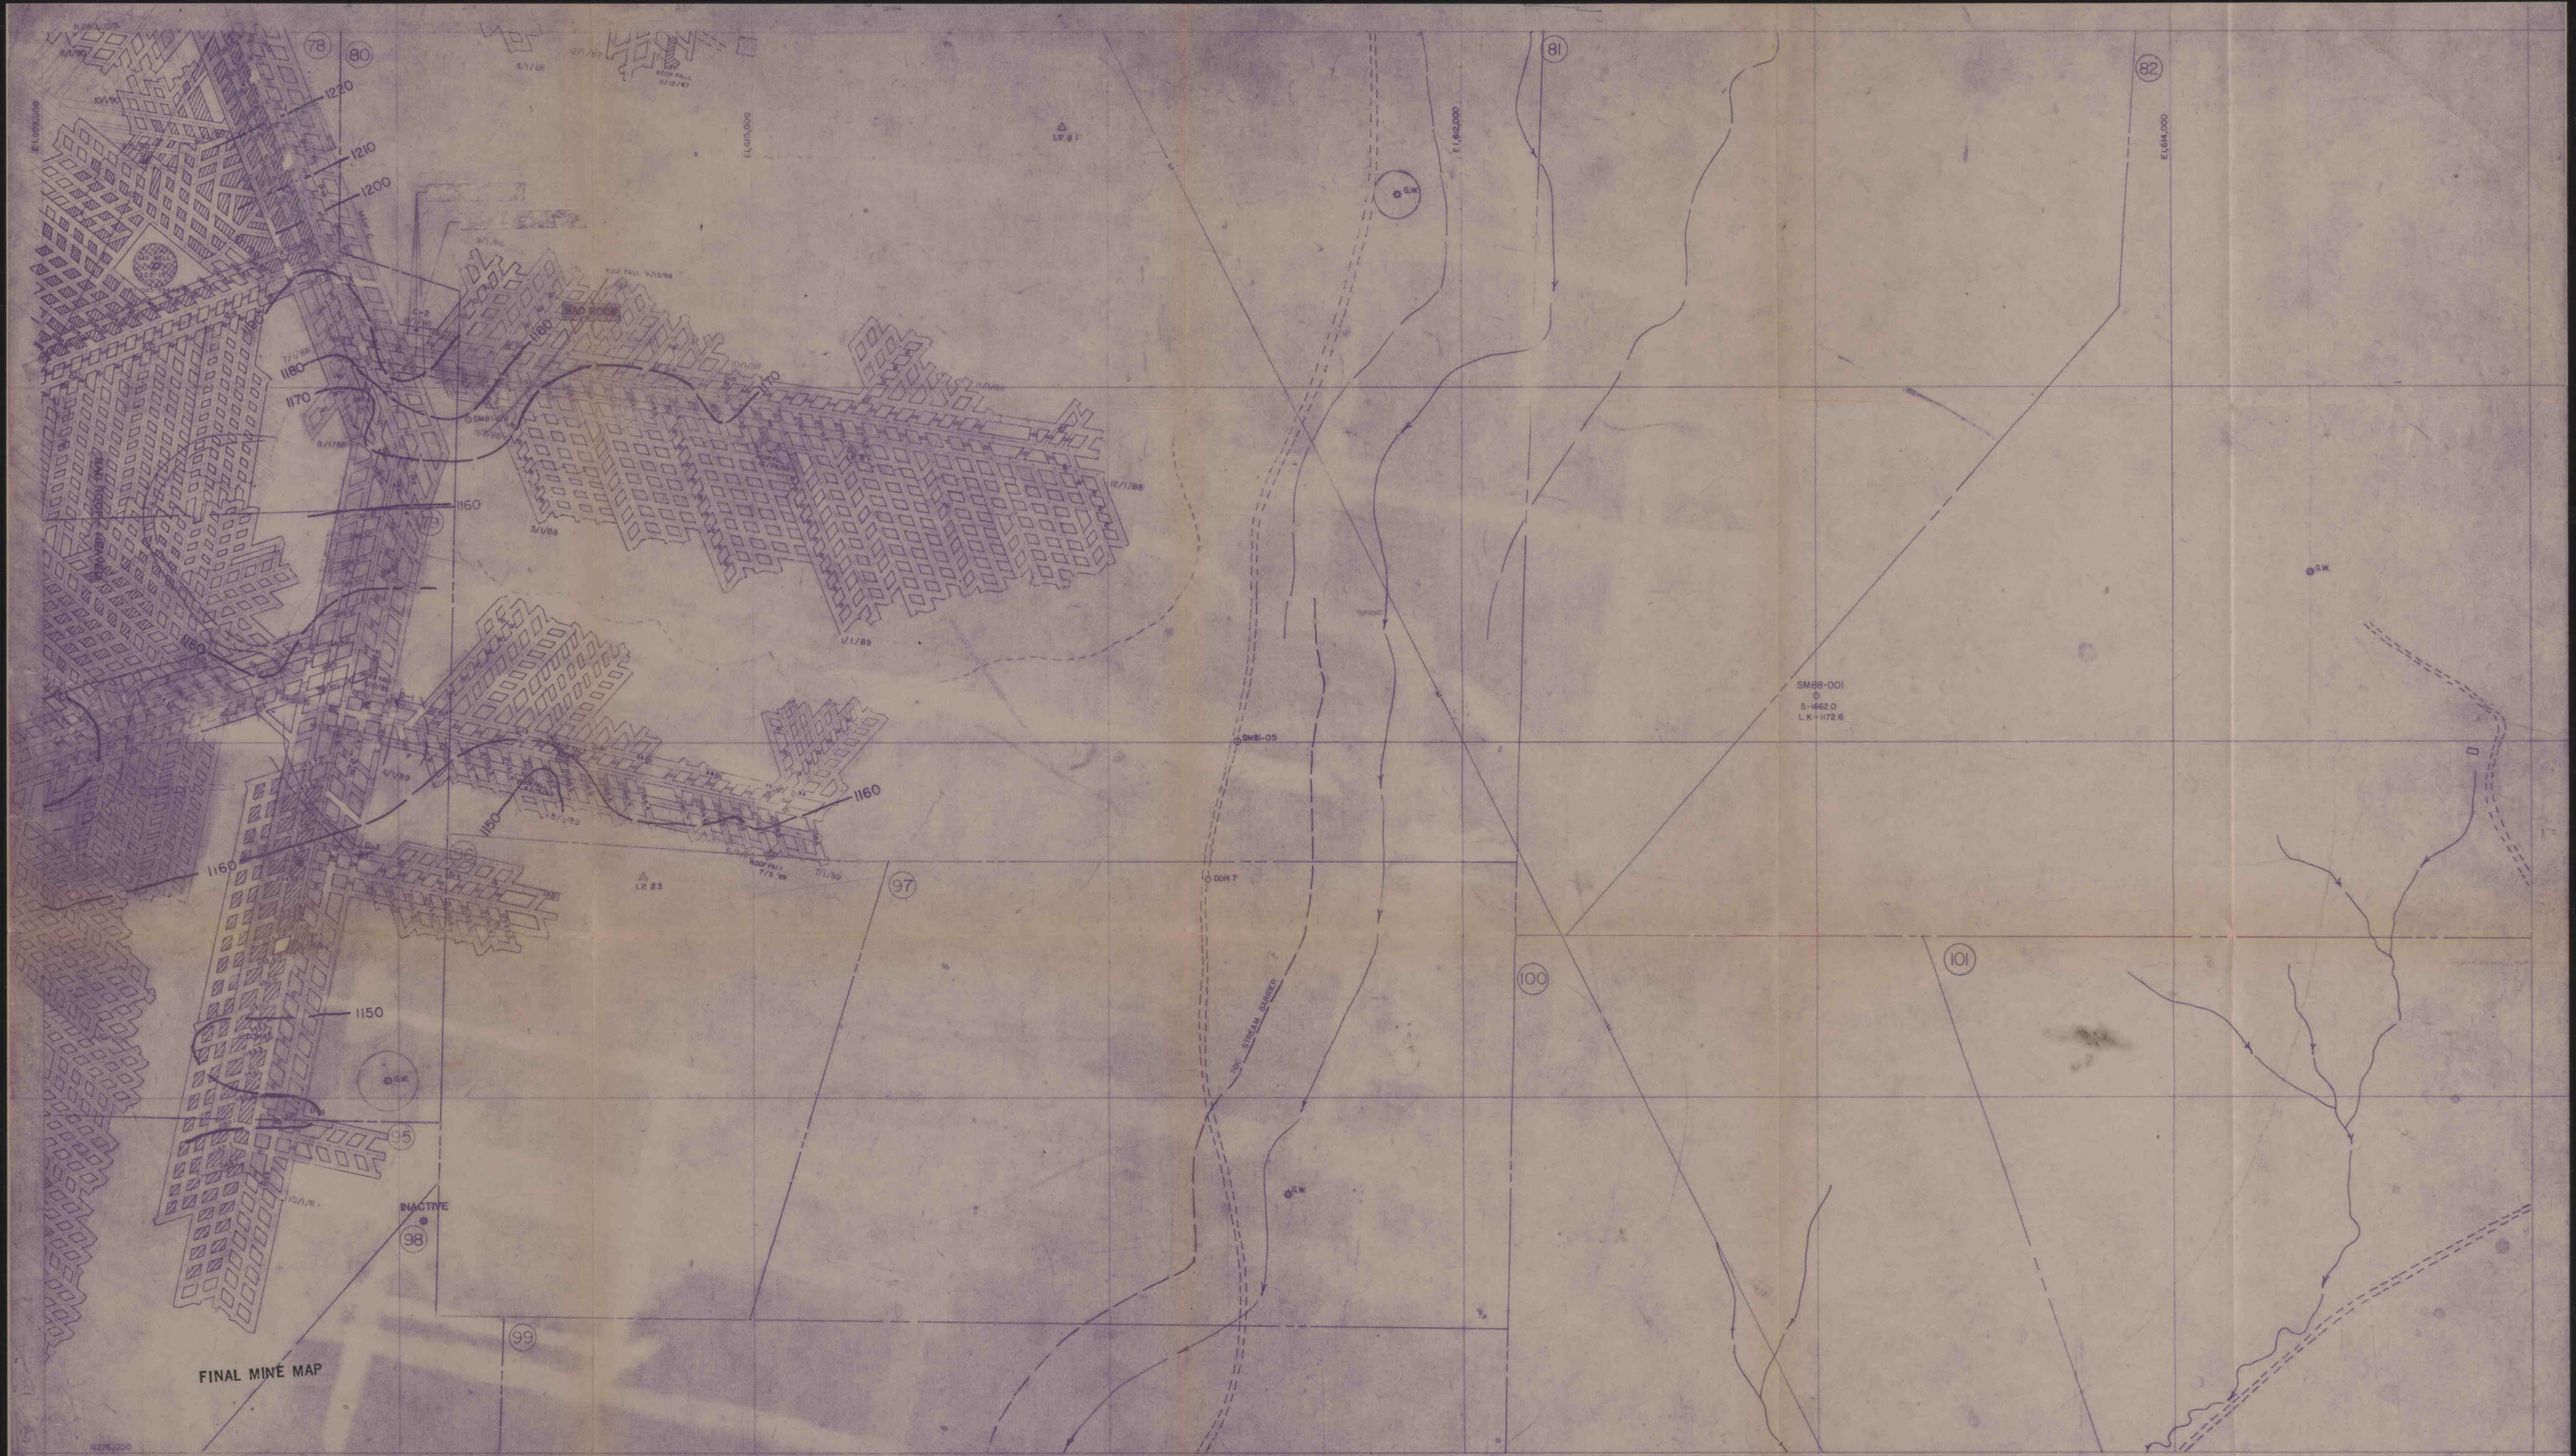
FINAL MINE MAP
BAD ROOF
INACTIVE
1220
1210
1200
1180
1170
1160
1150
SM88-001
S-1662.0
L.K.-1172.6
SM81-05
DDH 7
L.P. #1
L.P. #3
78
80
81
82
95
96
97
98
99
100
101
N
STANFORD
DOVERSPIKE BROS. COAL CO.
R.D. 4 BOX 271 PUNXSUTAWNEY, PA 15767
PORTER TWP., JEFFERSON CO.
SUGARCAMP No. 2
SHEET 1 OF 1 SCALE: 1" = 200'
EXHIBIT "B"
LEGEND
PERMIT AREA
PROPERTY LINES
PROPERTY OWNERS
CONTIGUOUS PROPERTY OWNERS
PRE 1966 DWELLINGS
DWELLINGS
PUBLIC BUILDINGS
L.K. COAL CONTOURS
L.K. COAL OUTCROP
GAS LINE
GAS WELL
MAJOR ELECTRIC LINE
WATER WELL
SPRING
DRILL HOLE
IMPOUNDMENT
CEMETERY
MINE OPENINGS, NOT SEALED
MINE OPENINGS, SEALED
STREAMS
SURVEY STATION
SUPPORT AREA (No Second Mining)
IMPOUNDED WATER (In Mine)
CONTEMPLATED MINING 2/15/93 TO 2/15/94
6 MONTH PROJECTIONS
GAS WELL BARRIER (No Mining Within Barrier Unless Approved)
PILLARS REMOVED
COMMONWEALTH OF PENNSYLVANIA
REGISTERED PROFESSIONAL
JOSEPH P. KALYNIUK
ENGINEER
Joseph P. Kalyniuk
5-4-93
DOVERSPIKE BROS. COAL CO.
DATE:
SUGARCAMP No.2 MINE
SCALE: 1" = 200'
INTAKE AIR
RETURN AIR
PRIMARY ESCAPEWAY
SECONDARY ESCAPEWAY
BELT LINE
B-E POINTS (Approved)
B-E POINTS (Proposed)
STOPPING
STOPPING W/ DOOR
CHECK CURTAIN
REGULATOR
DOUBLE DOORS(Equip. doors)
OVERCAST
REGULATING OR RUN-THROUGH CHECK
Survey is closed loop. Accuracy is 1:10000
Individuals responsible for information:
Mark Pennsy, Engineer & Larry Smith, Superintendent