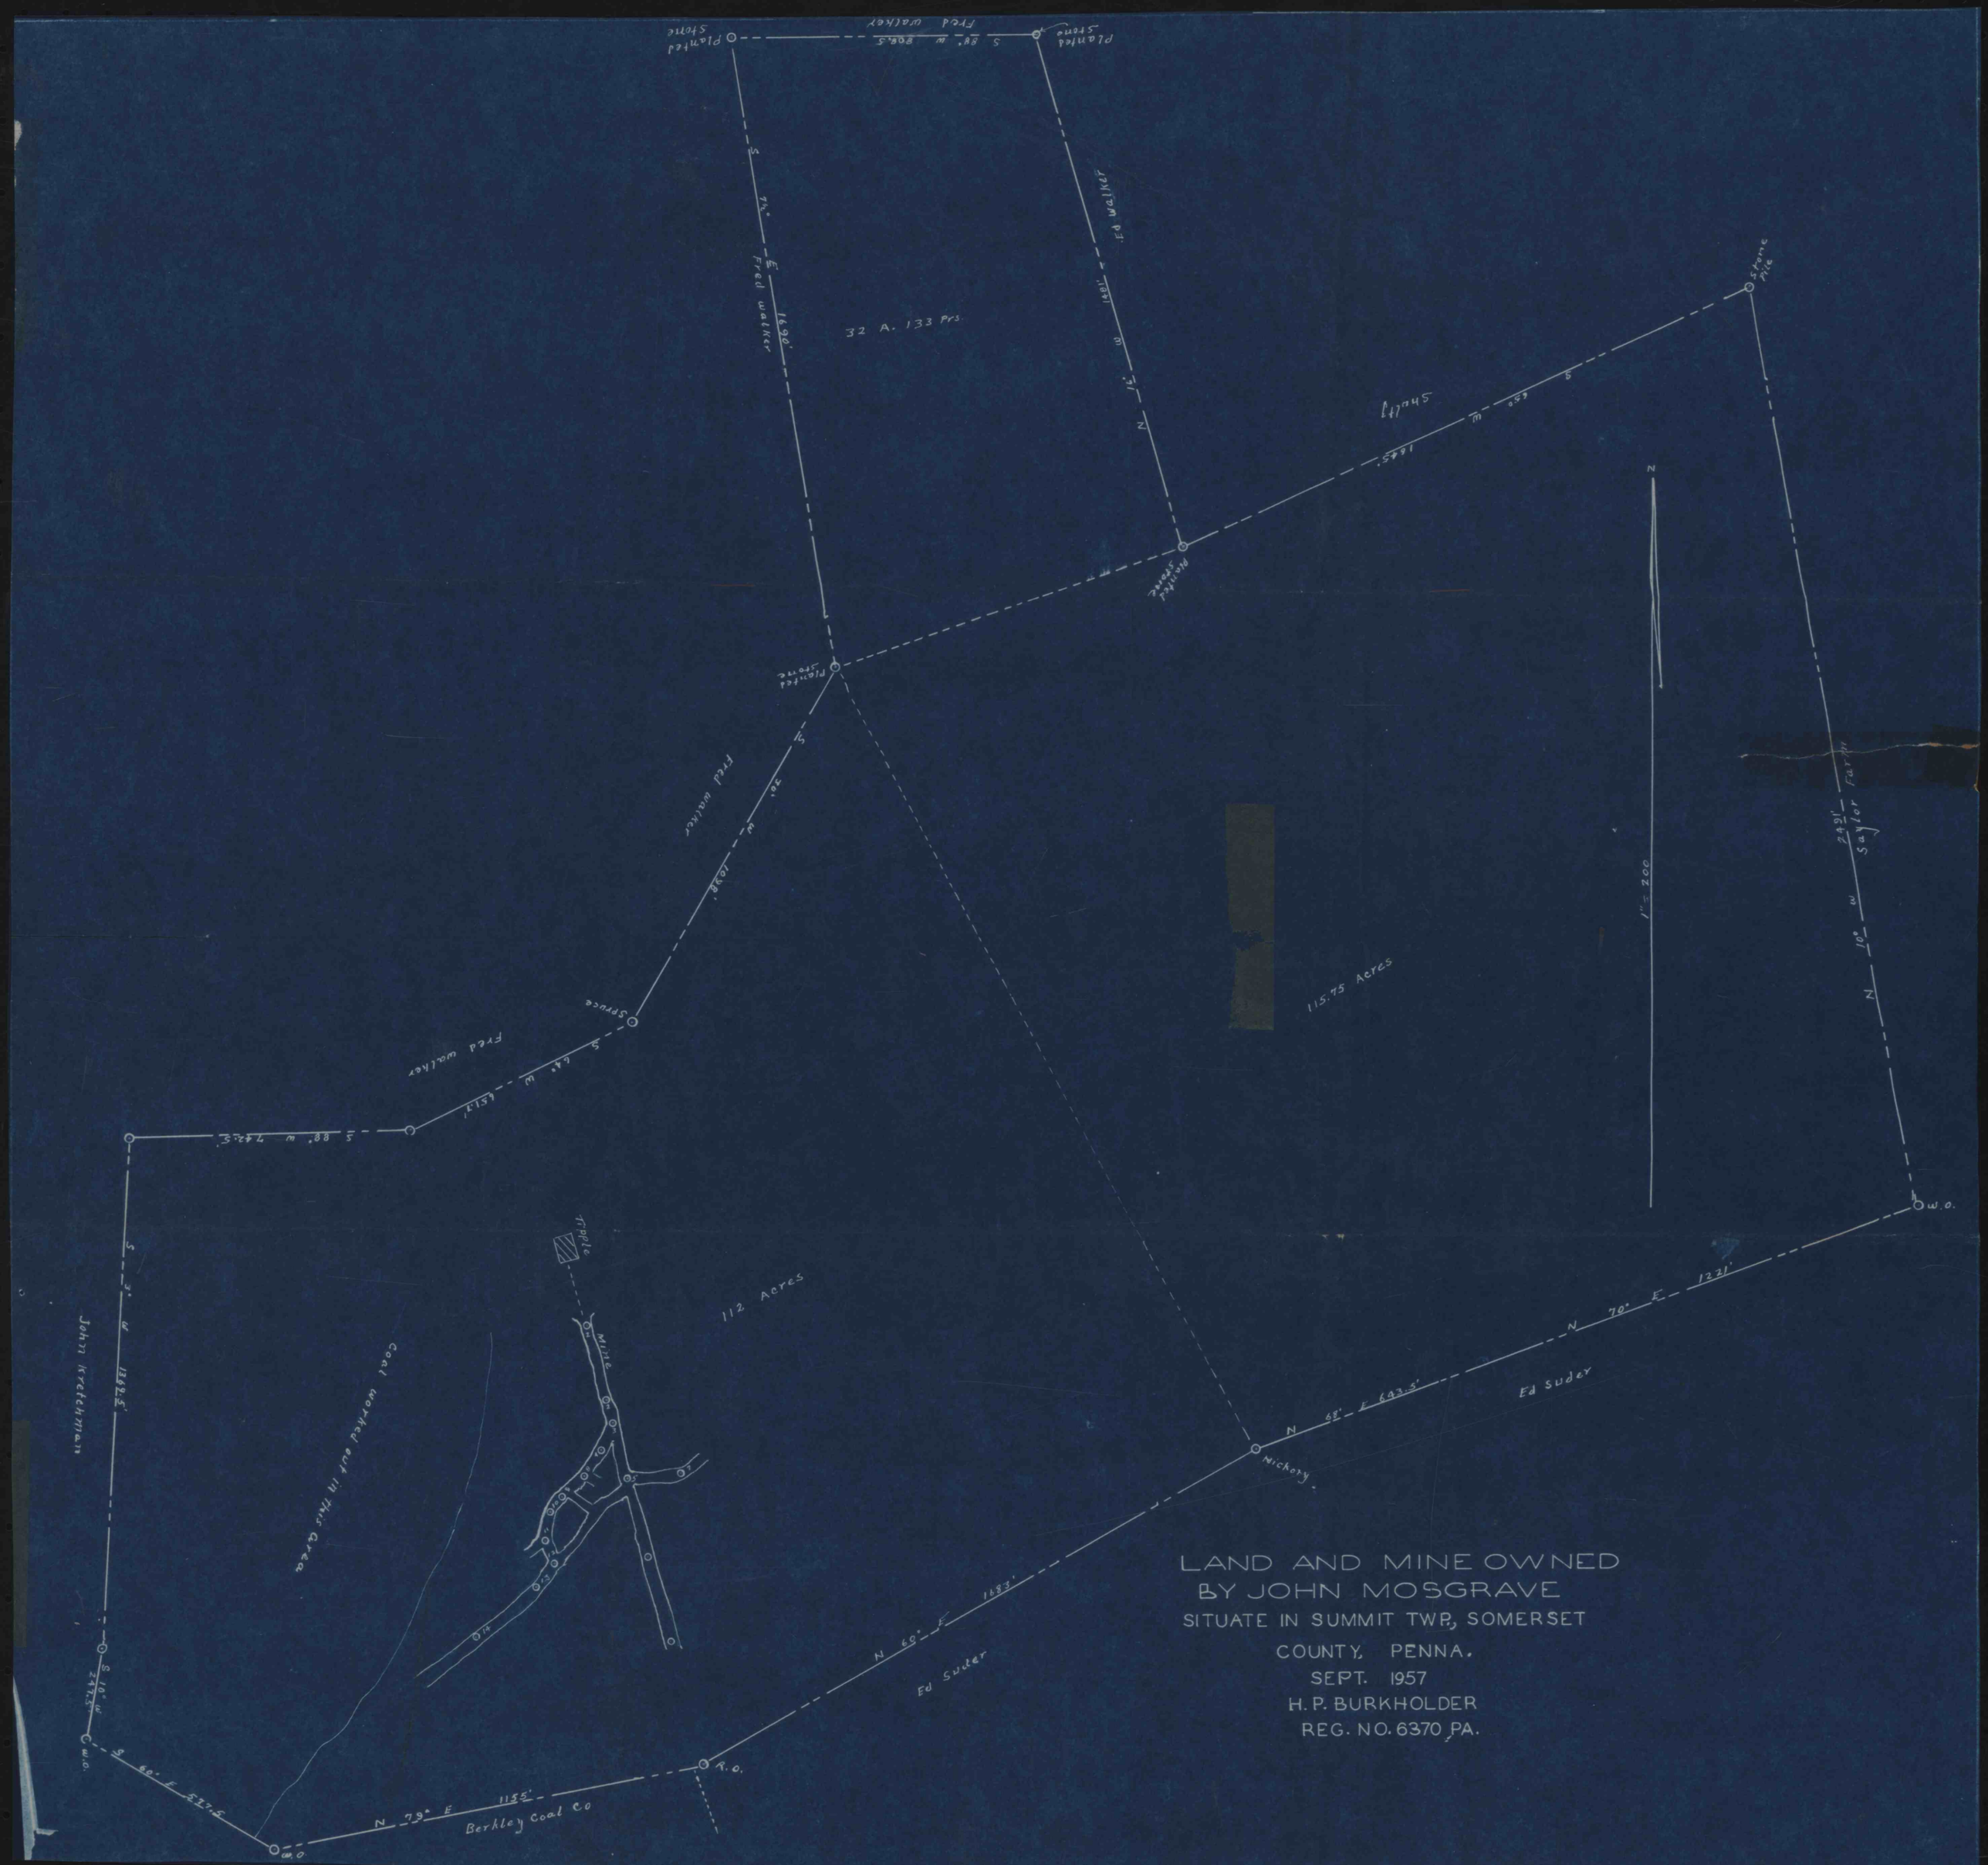

LAND AND MINE OWNED BY JOHN MOSGRAVE

SITUATE IN SUMMIT TWP., SOMERSET COUNTY, PENNA.

SEPT. 1957

H. P. BURKHOLDER

REG. NO. 6370, PA.