
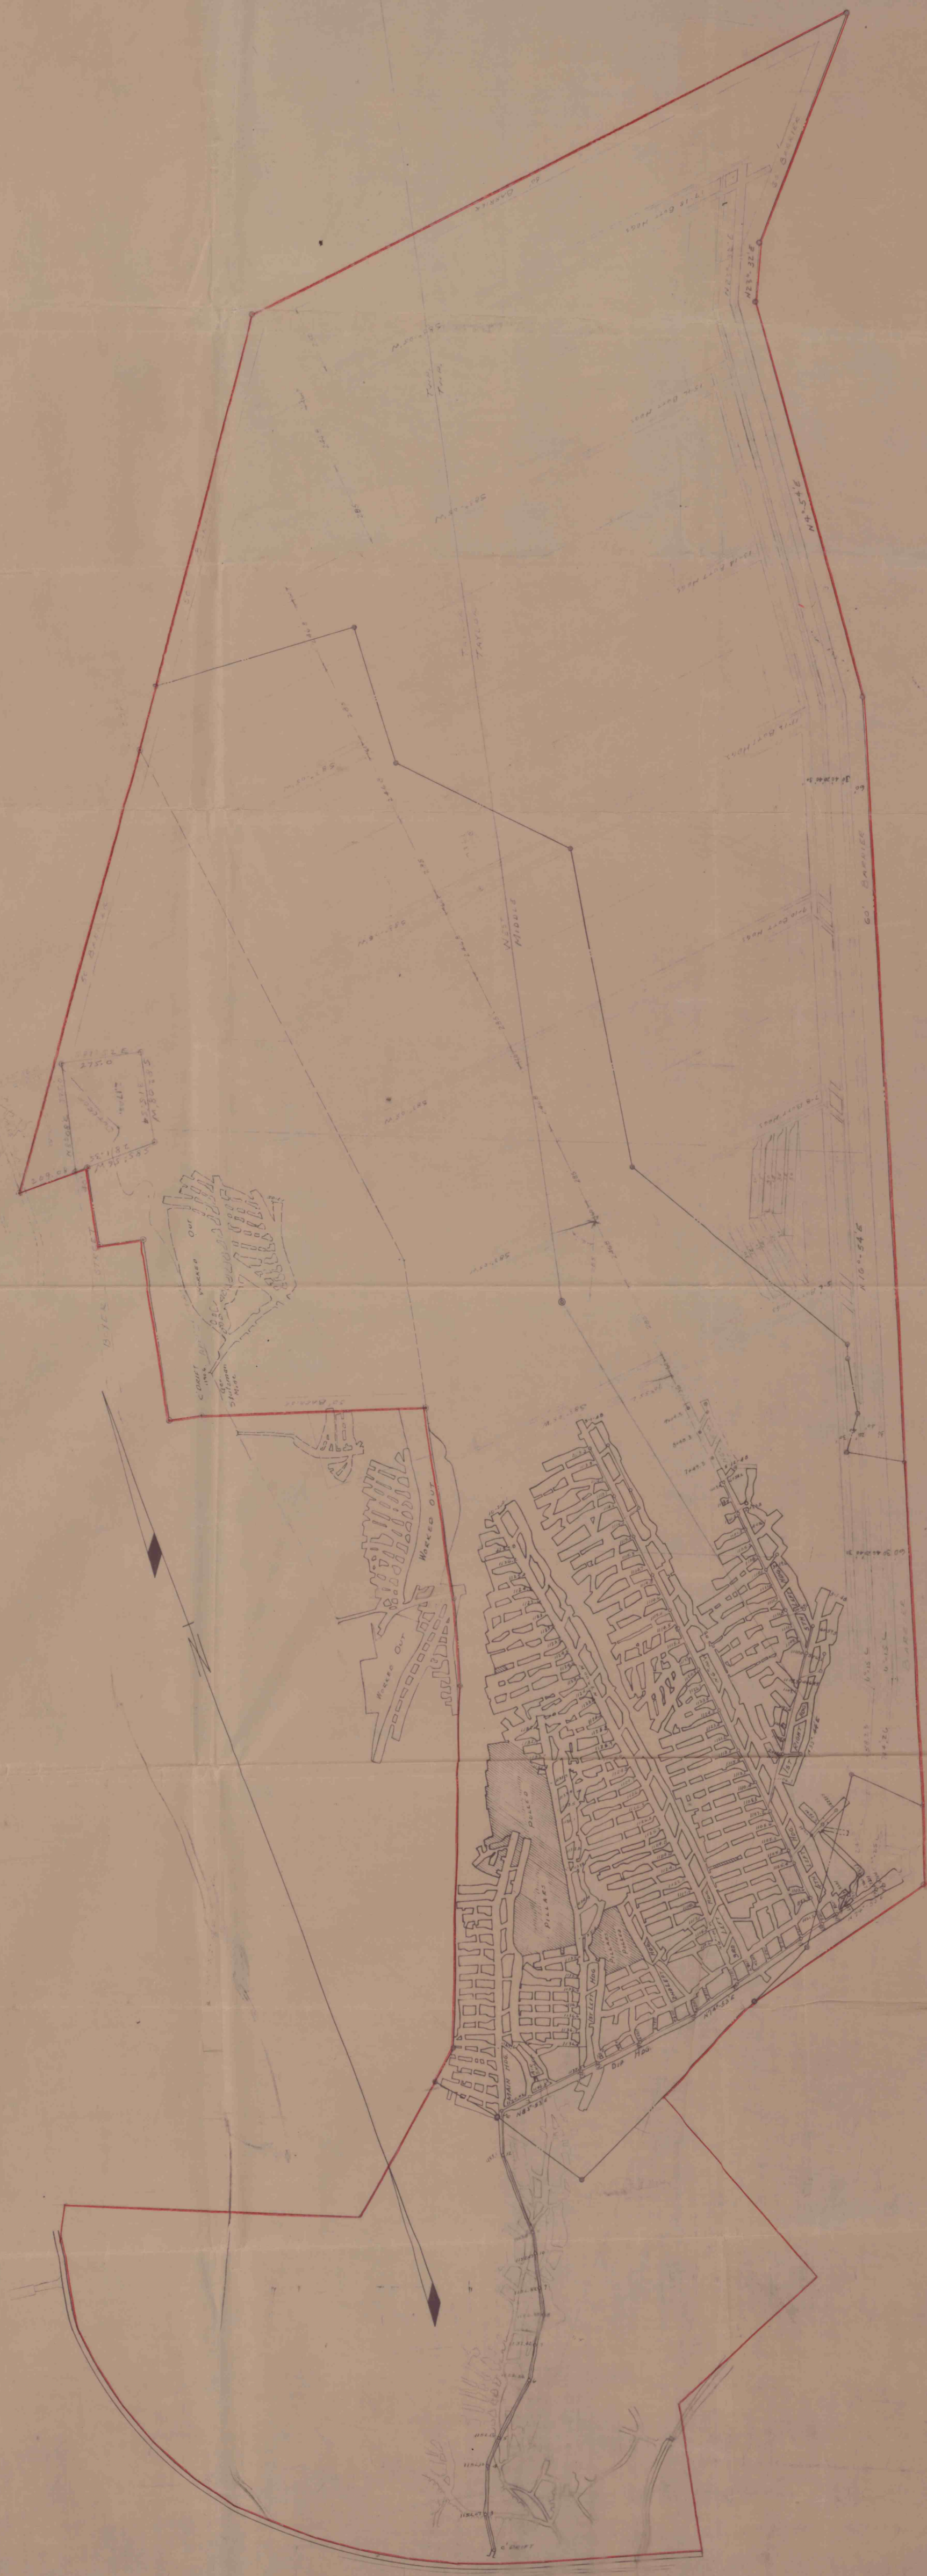


MAP SHOWING
C-PRIME MINING OPERATIONS
28
1926

OF THE
CURRY COAL COMPANY
Now **STANDARD COLLIERIES**
FORMERLY DAVID DIBERT MINES, INC.

SITUATE IN
WEST AND MIDDLE TAYLOR TOWNS, CAMBRIA CO., PA.
SCALE: 1" = 200'
JAN. 5, 1926
LETTERMAN ENG. CO.

 INDICATES LIMIT OF COAL FIELD
NO OIL OR GAS WELLS



Part of 11-10-1926