



 PHOTOGRAPH DATES: 5-8-83

TUNNELTON MINING COMPANY
 MARION MINE U.S.M. NO. 36 00929
 Location: CONEMAUGH TWP. INDIANA CO. PA.
 ASB 893 Box 327 EBENSBURG, PA 15931

TUNNELTON MARION MINE
 SCALE 1"=200'
 SHEET K-6
 INDIANA & WESTMORELAND COUNTIES

FINAL MINING COMPLETED ON 3-16-94.
 AN UNDERGROUND INSPECTION OF THE FACES
 OF ALL THE FORMERLY ACTIVE SECTIONS
 WAS MADE BY DEEP MINE SAFETY INSPECTOR,
 JOSEPH J. ARDINI ON 6-29-94.

TUNNELTON MINING CO.
MARION MINE

MINING ACTIVITY PERMIT NO. 32841310

UPPER FREEPORT "E" SEAM


CONEMAUGH TWP. PROJECTION: INDIANA CO., PA.

DERRY & LOYALHANNA TWP. WESTMORELAND CO., PA.

SCALE 1"=200' SURVEY DATE 4-1-94

PERIOD COVERED 7-1-94 TO 1-1-95

- DWELLINGS & CEMETERIES (IN PLACE BEFORE 1966 ACT) ■
- PUBLIC BUILDINGS ■
- PERMIT BOUNDARY ■
- POLITICAL SUBDIVISION BOUNDARIES ■
- SIX MONTH SUBSIDENCE CONTROL BOUNDARY ■
- SUBSIDENCE CONTROL BOUNDARY ■
- MINING COMPLETED AREA ■
- PILLARS EXTRACTED ■
- CALCULATED SUPPORT AREA ■
- COAL PILLAR SUPPORT AREA ■
- DO NOT MINE (NO RIGHT OF ENTRY) ■
- FEATURE IDENTIFICATION NO. IW
- SURFACE OWNERSHIP (ON PROPERTY MAP PRINTS) OI-OI-DDI

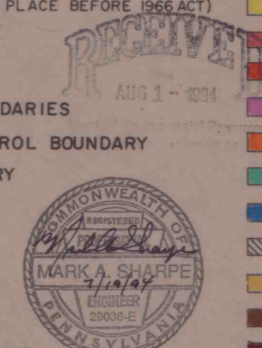

MINERAL OWNERSHIP (All Tracts, Westmoreland Co., leased from
 Royal Oil & Gas, Except TMC lease from Paul Long; Exh.C for details)
 MINING WILL BE ON PROJECTED CENTERLINES, ENTRY WIDTHS
 SHALL NOT EXCEED 20 FEET IN SUPPORT AREAS

RECEIVED
 Ebensburg, PA
 Bureau of Mining & Reclamation