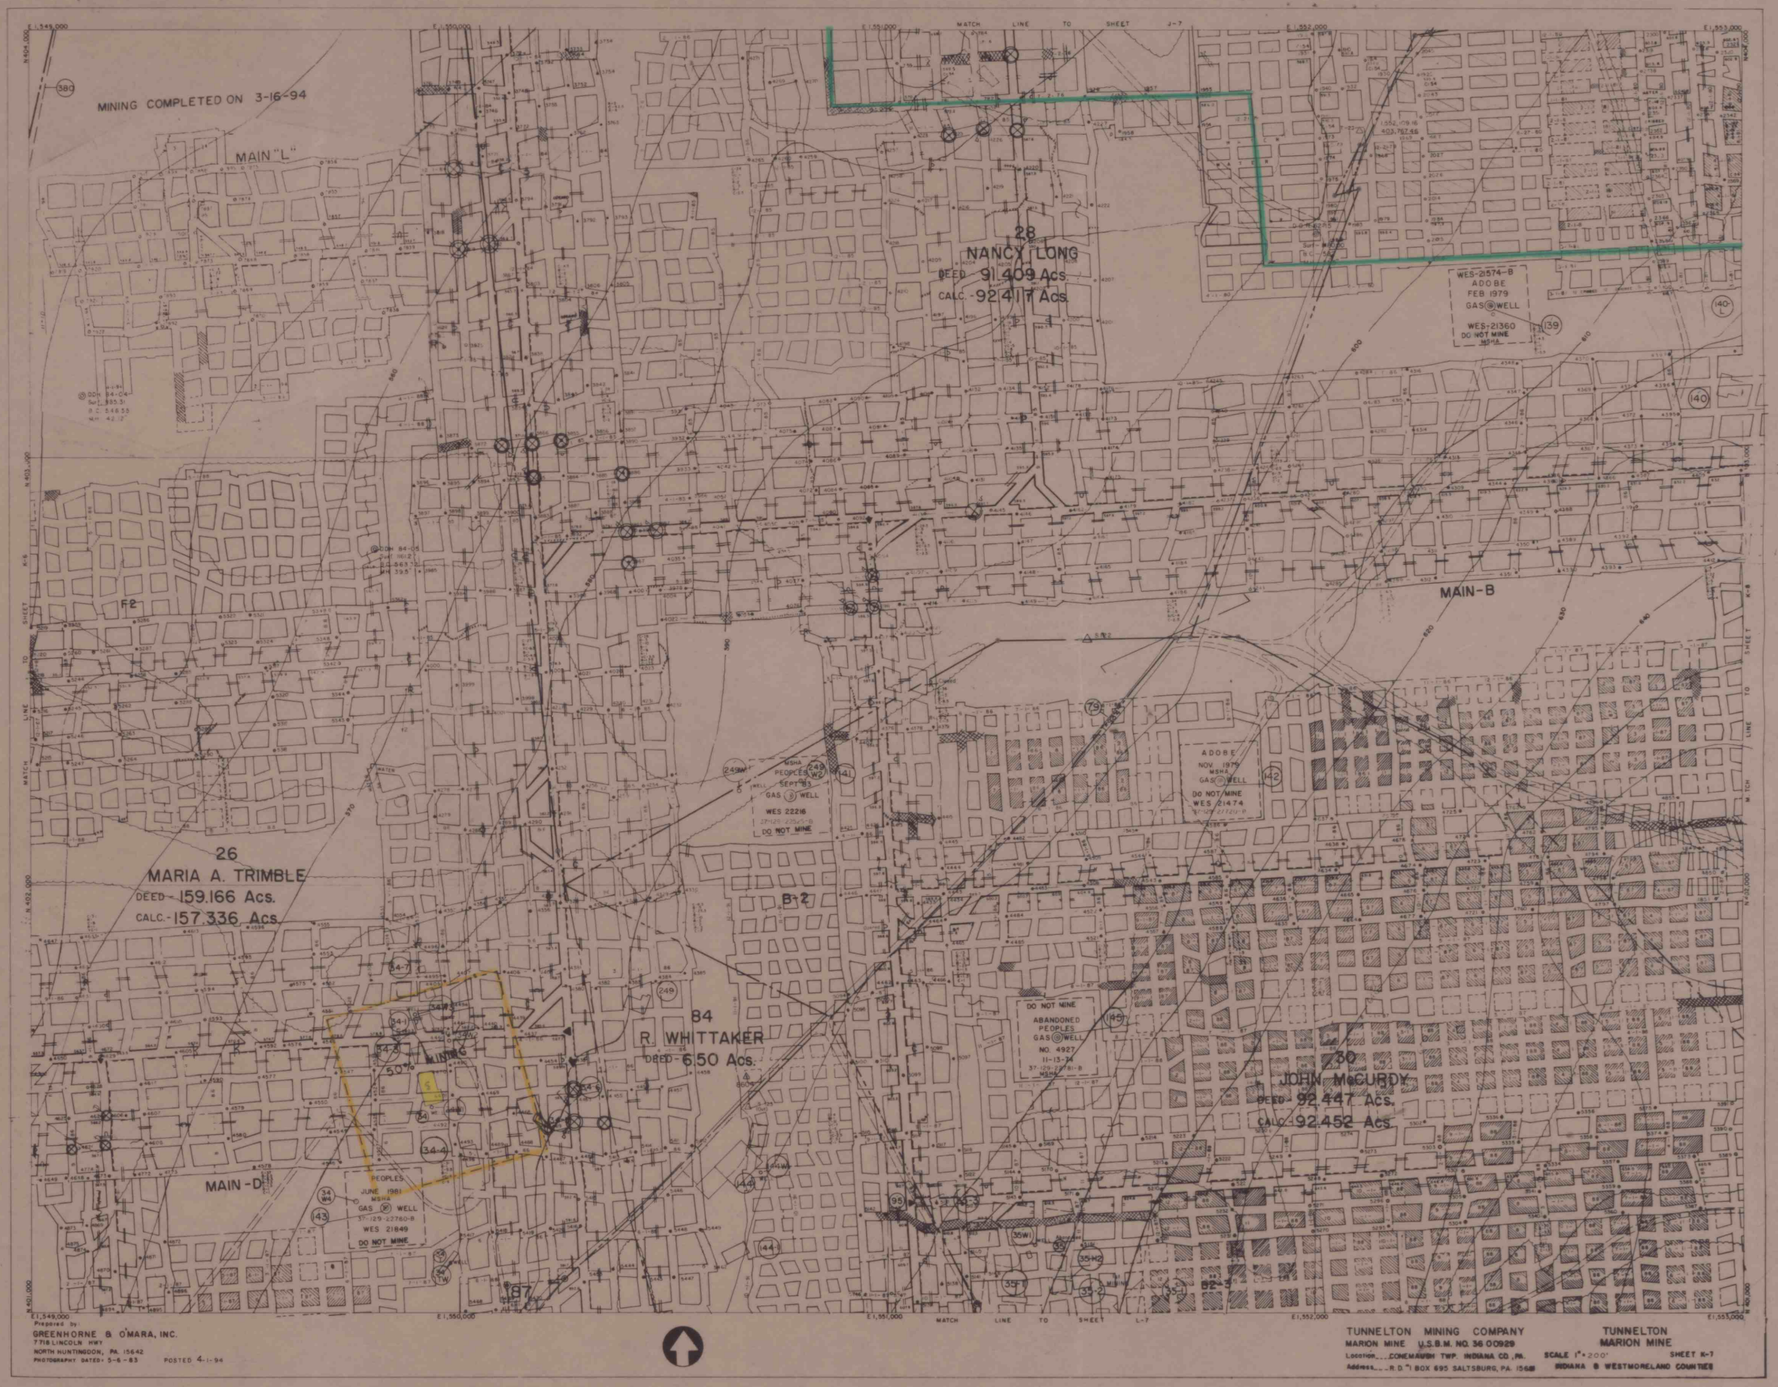

Prepared by
GREENHORNE & O'MARA, INC.
7718 LINCOLN HWY
NORTH HUNTINGDON, PA. 15642
PHOTOGRAPHY DATED: 5-6-83 POSTED 4-1-94

TUNNELTON MINING COMPANY
MARION MINE U.S.B.M. NO. 36 00929
Location CONEMAUGH TWP. INDIANA CO., PA.
Address R.D. 1 BOX 695 SALTSBURG, PA. 15681

TUNNELTON
MARION MINE
SCALE 1"=200' SHEET K-7
INDIANA & WESTMORELAND COUNTIES

FINAL MINING COMPLETED ON 3-16-94.

AN UNDERGROUND INSPECTION OF THE FACES OF ALL THE FORMERLY ACTIVE SECTIONS WAS MADE BY DEEP MINE SAFETY INSPECTOR, JOSEPH J. ARDINI ON 6-29-94.

TUNNELTON MINING CO.

MARION MINE

MINING ACTIVITY PERMIT NO. 32841310

UPPER FREEPORT "E" SEAM

CONEMAUGH TWP. PROJECTION: INDIANA CO., PA.

DERRY & LOYALHANNA TWPS. WESTMORELAND CO., PA.

SCALE 1"=200' SURVEY DATE 4-1-94

PERIOD COVERED ——— 7-1-94 TO 1-1-95

DWELLINGS & CEMETERIES (IN PLACE BEFORE 1966 ACT)

PUBLIC BUILDINGS

PERMIT BOUNDARY

POLITICAL SUBDIVISION BOUNDARIES

SIX MONTH SUBSIDENCE CONTROL BOUNDARY

SUBSIDENCE CONTROL BOUNDARY

MINING COMPLETED AREA

PILLARS EXTRACTED

CALCULATED SUPPORT AREA

COAL PILLAR SUPPORT AREA

DO NOT MINE (NO RIGHT OF ENTRY)

FEATURE IDENTIFICATION NO. (IW)

SURFACE OWNERSHIP (ON PROPERTY MAP PRINTS) 01-01-001

MINERAL OWNERSHIP (All Tracts, Westmoreland Co., leased from Royal Oil & Gas, Except TMC lease from Paul Long; Exh.C for details) JOHN DOE 00.00 Ac.

MINING WILL BE ON PROJECTED CENTERLINES, ENTRY WIDTHS SHALL NOT EXCEED 20 FEET IN SUPPORT AREAS

RECEIVED
AUG 1 0 1994
Department of Environmental Protection
Mahoney District Office

COMMONWEALTH OF PENNSYLVANIA
REGISTERED
MARK A. SHARPE
ENGINEER
29036-E
7/19/94

RECEIVED
AUG 10 1994
Ebensburg, PA
Bureau of Mining & Reclamation