

MINE MAP
GEORGE SOLTIS & SONS COAL CO.
COAL MINE

Banks Township, Indiana County, Pa.

Scale 1"=200' August 28, 1957

Walter J. Zimmerman Surveyor Engineer Punxsutawney, Pa.

12-1961

SARAH JOHNSTON


JAMES RADCLIFFE

GILBERT MERRLING
(Surface)
GEORGE SOLTIS
(Coal)

GEORGE SOLTIS
(Coal and Surface)

AUGUST SAULSTROM

J.O. CLARK Heirs.

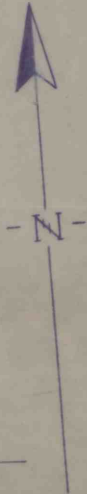

To ROSSITER


TOWNSHIP ROAD 972

State Route L.R. 572
Concrete Pavement

Traffic Route 336

To Gen. Campbell

OLD WORKING

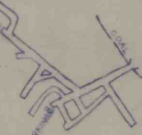

OLD WORKING

OLD WORKING

STRIPPED PIT/SHALE