

**CONSOLIDATION COAL CO.
BLACKSVILLE MINE NO. 2**

WAYNE TWP GREENE COUNTY PENNA.
SCALE: 1"=200' SURVEY DATE 10-17-94

R. MICHAEL ROHALY JR.
PE-030100E

LEGEND

CONTEMPLATED MINING 7-1-94 TO 12-31-94

SUPPORT AREA CALCULATED & ACTUAL

PROTECTED STRUCTURE

UNPROTECTED STRUCTURE

MINING COMPLETED AREA


PERMIT BOUNDARY LINE

SUBSIDENCE CONTROL PLAN BOUNDARY

ENTRY WIDTH IS 14' WIDE AND CROSSCUTS VARY IN LENGTH
FROM 50' TO 115'. THE 7' PITTSBURGH SEAM BEING MINED IS
OWNED BY CONSOLIDATION COAL COMPANY.
ANY PILLAR THAT EXCEEDS OR TOUCHES
CALCULATED SUPPORT AREA WILL
REMAIN IN PLACE.

SHEET INDEX LETTER REFER TO 5 YEAR PLAN FOR COMPLETE PROPERTY LISTING

K

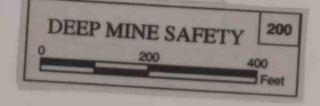

K