


CARPENTERTOWN COAL & COKE CO.  
TEMPLETON, PENNSYLVANIA  
MAHONING CREEK NO. 2 MINE

CARPENTERTOWN COAL & COKE CO.  
TEMPLETON, PENNSYLVANIA  
MAHONING CREEK NO. 2 MINE

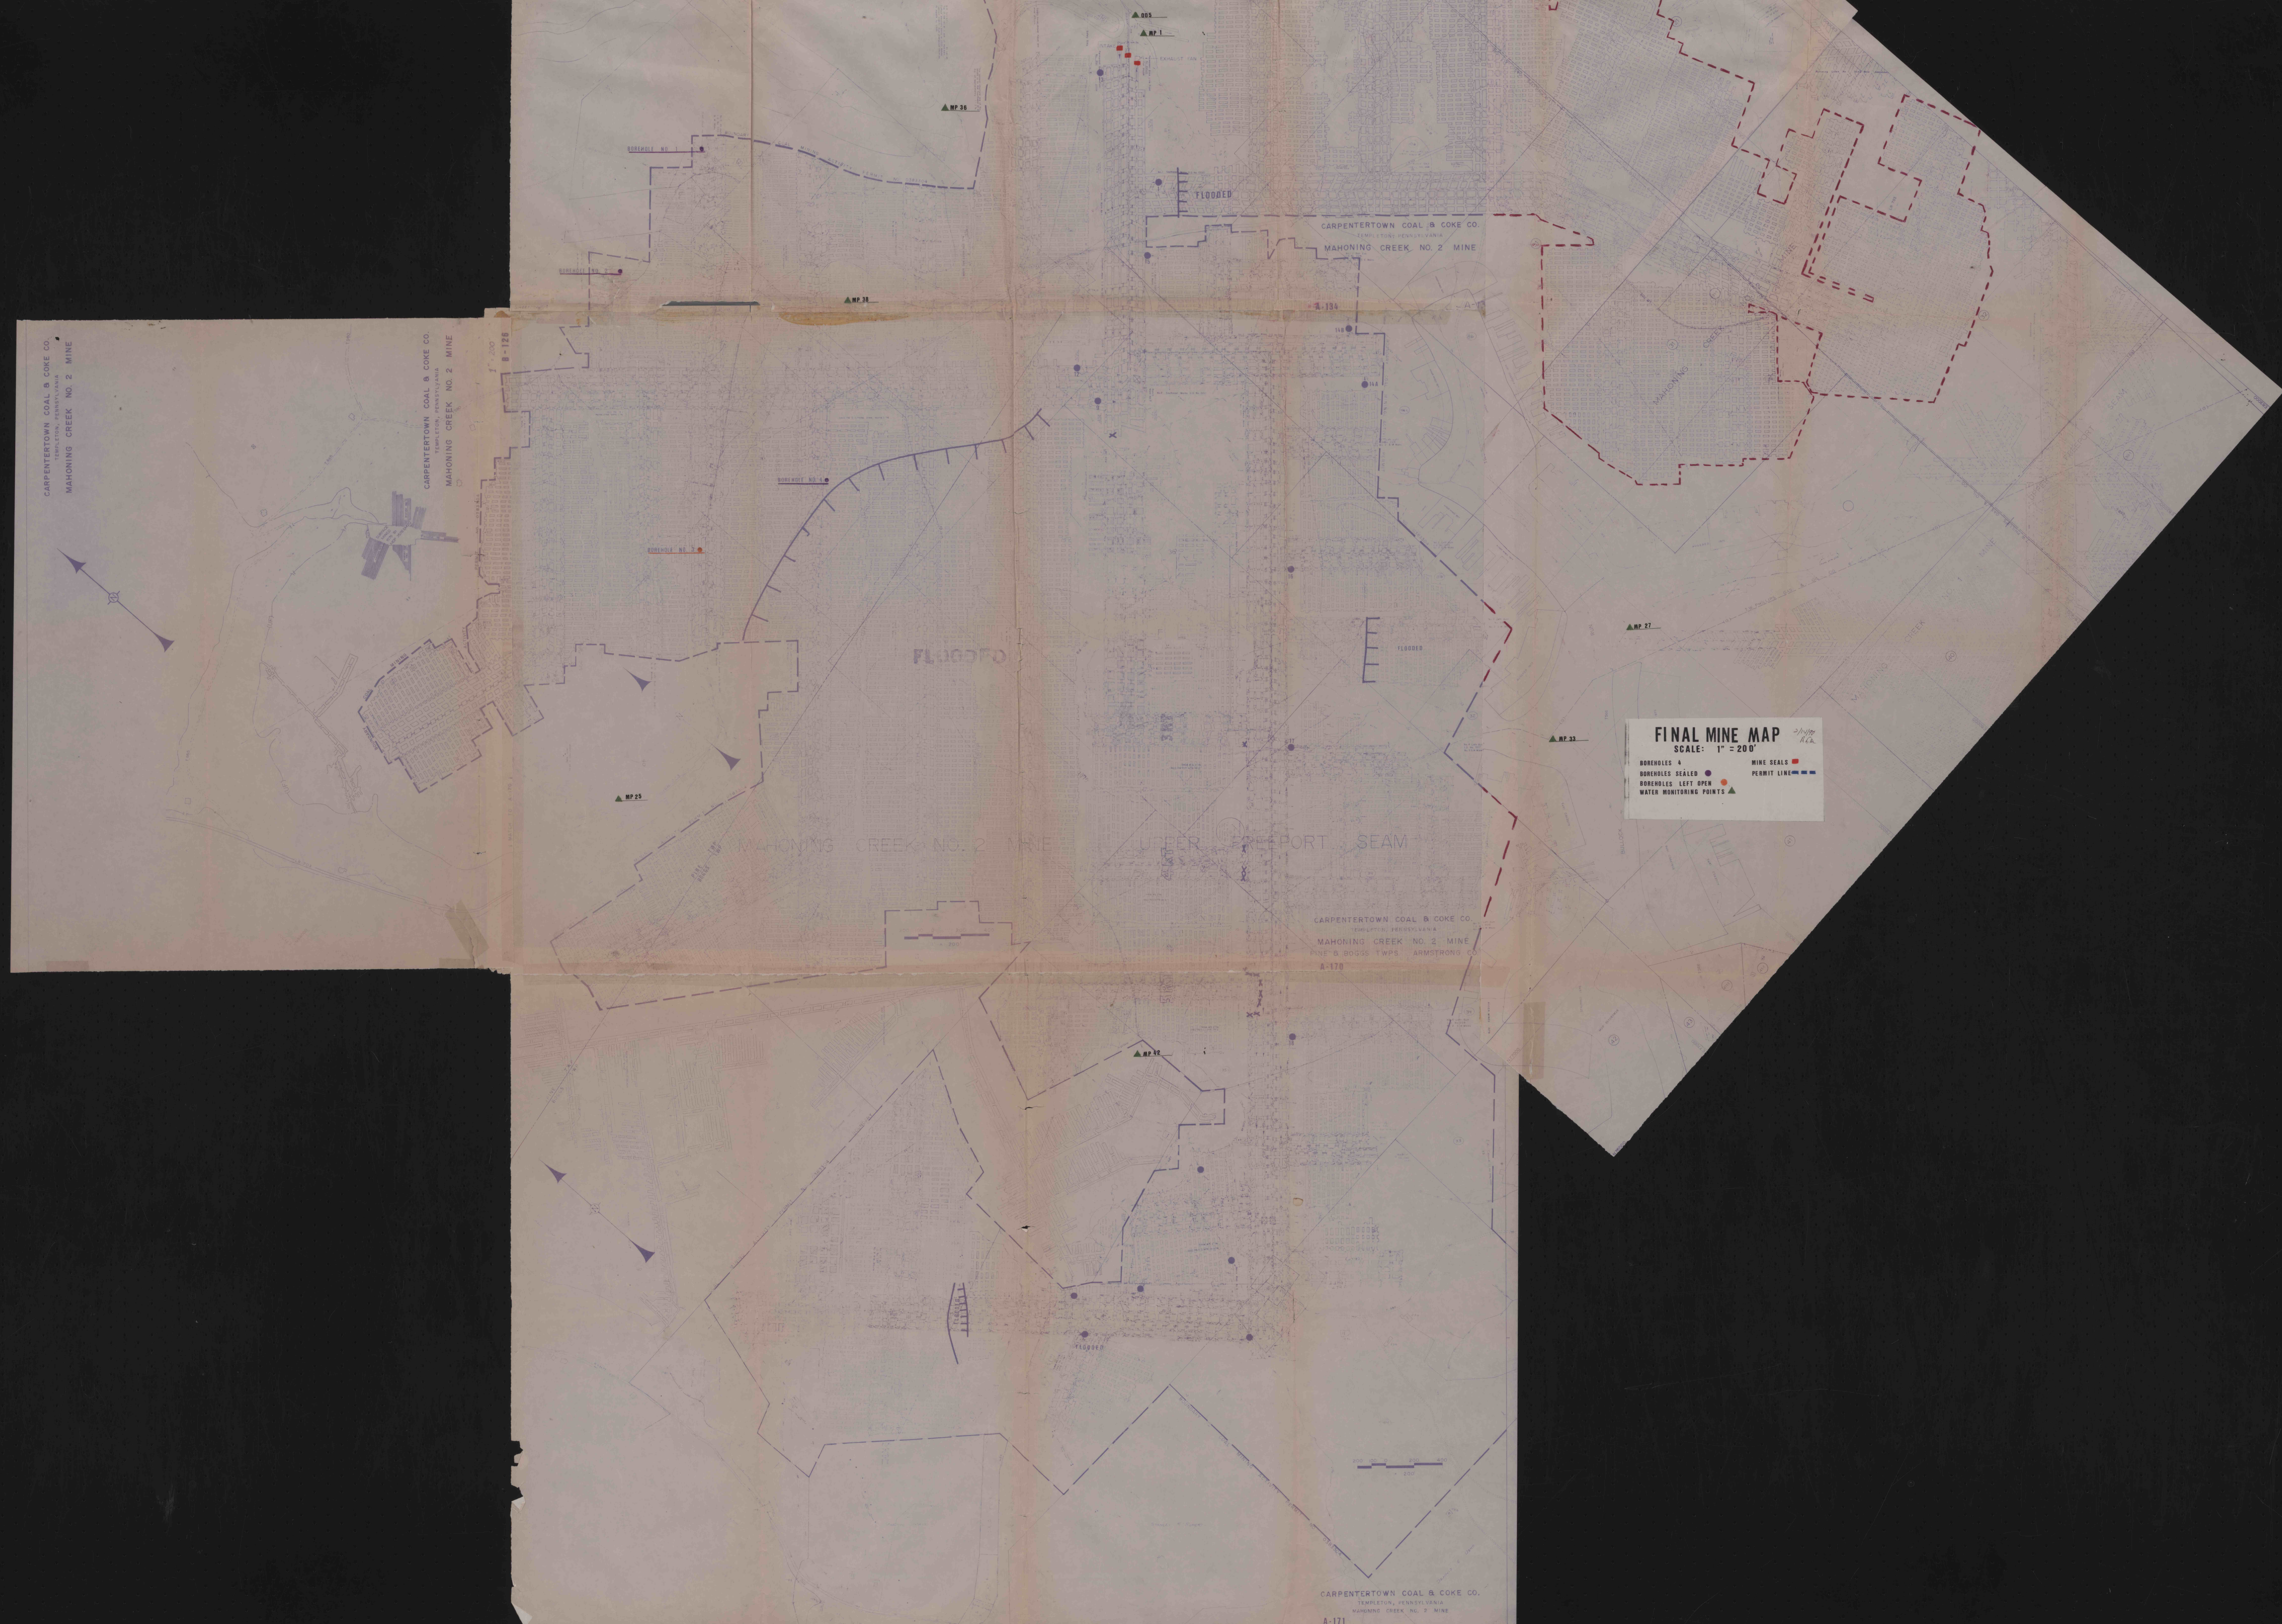

**FINAL MINE MAP**  
SCALE: 1" = 200'  
MINE SEALS (red square), PERMIT LINES (blue dashed line)

CARPENTERTOWN COAL & COKE CO.  
TEMPLETON, PENNSYLVANIA  
MAHONING CREEK NO. 2 MINE  
A-171