


WALTER COCHRAN

CHARLES HAWTHORN

WALTER COCHRAN

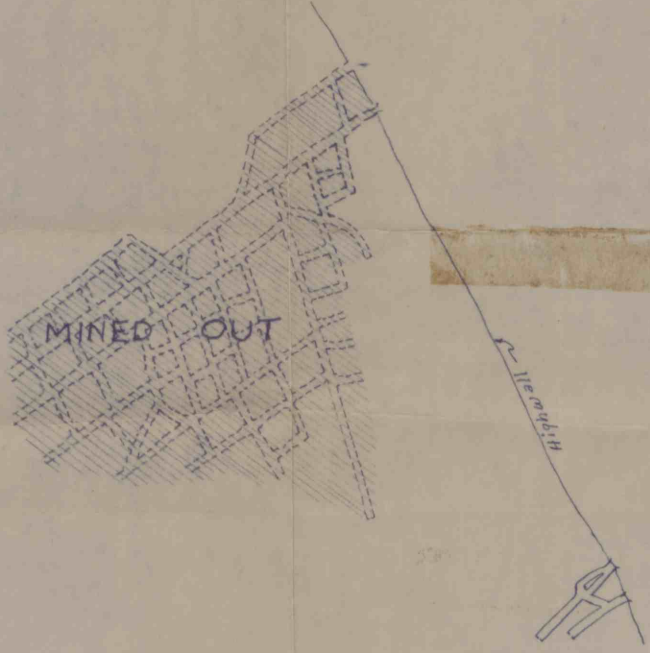

Gas Well

Private Road

To Coalspring  
Township Road No. 368  
To Spruce Mills



HARRY CAYLOR

L. E. STARTZELL

EARL COVERT

MINE MAP  
**JOHN HIMES**  
 COAL MINE

Oliver Township, Jefferson County, Pa. 12  
 Scale 1"=200' Oct. 3, 1937  
 Walter J. Zimmerman Surveyor Engineer Piquette, Pa.