

N 0000
11000 E

N 0000
8000 E

+

+

+

CHAS. RUPERT

N 00011 EDWARD BUHITE


11000 E

DIP 0-05'



BOLLINGER NO. 2
 BURRELL TWP., ARMSTRONG CO., PA.
 SCALE: 1" = 200' JULY 5, 1969
 BY: CHAS. KRAVETSKY ES 12782 E
 NOTE: WORKINGS SHOWN ARE TAKEN FROM
 MAP OF "FORREST MINE"

— LEGEND —
 CONTEMPLATED MINING 8-6-71 TO 2-6-72
 SUPPORT AREA
 PROTECTED STRUCTURES
 MINING COMPLETED AREA
 PERMIT AREA

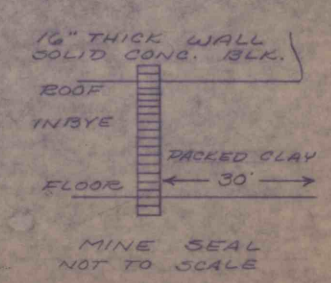

Charles J. Kravetsky