


Notes:  
 Hole 1 - Monitor Hole  
 Hole 2 - Water Flush  
 Hole 3 - Hold thru  
 (Proposed)  
 Impoundment Area  
 Fire Area  
 Location  
 Remote placed seal  
**LEGEND**

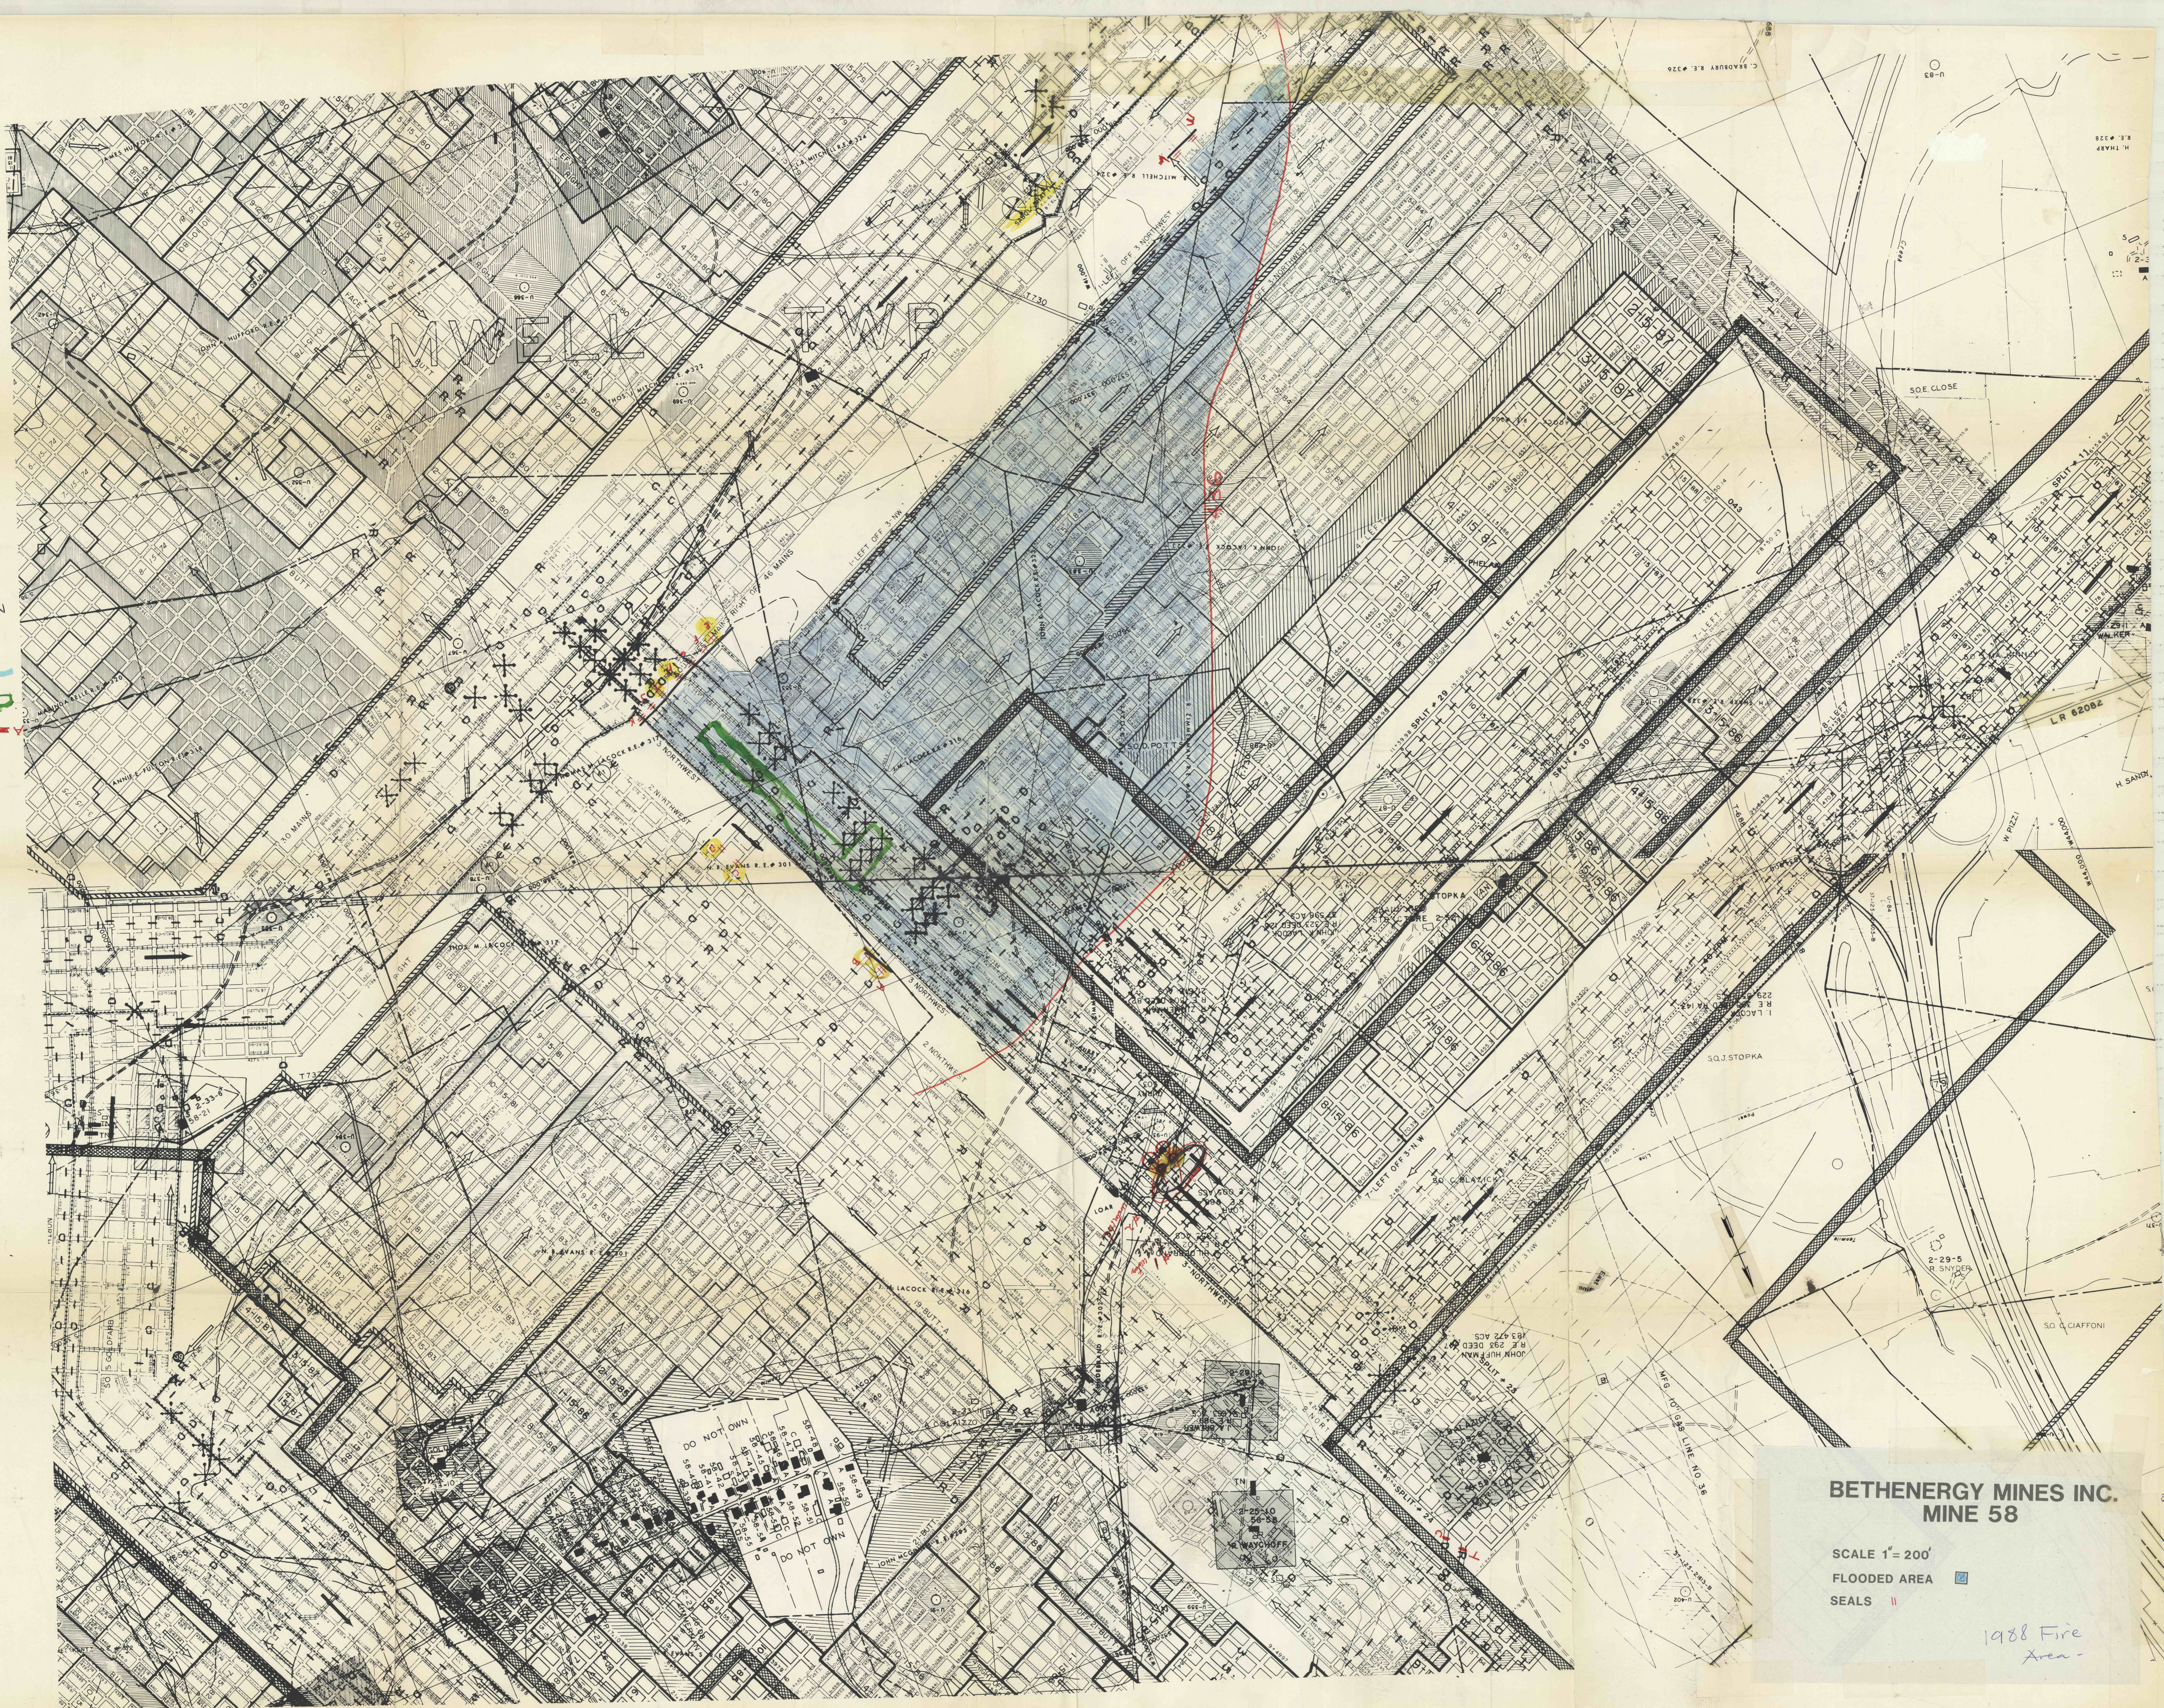

**BETHENERGY MINES INC.  
MINE 58**

SCALE 1" = 200'  
 FLOODED AREA ■  
 SEALS ■

1988 Fire Area