

PALMER MINE

UNITED STATES STEEL CORPORATION


FAYETTE COUNTY PA. German Twp.

SCALE 1 INCH = 100 FT.


DATUM OF LEVELS
U. S. GEOLOGICAL SURVEY

DATE OF LAST SURVEY

DATE	Survey Letter	Plotted By	Checked By	DATE	Survey Letter	Plotted By	Checked By
2-10-10	A	WGL	WGL	11-14-46	B-4	WGL	WGL
5-10-10	B	WGL	WGL	5-20-47	C-4	R.H.	R.H.
8-5-10	C	WGL	WGL	10-17-47	D-4	WGL	WGL
11-5-10	D	WGL	WGL	5-14-48	F-4	R.H.	R.H.
10-19-11	E	WGL	WGL	11-10-48	F-4	WGL	WGL
5-7-12	F	WGL	WGL	5-5-49	G-4	WGL	WGL
5-11-12	G	WGL	WGL				
5-10-17	H	WGL	WGL	4-27-50	I-4	R.P.	R.P.
11-10-17	I	WGL	WGL	10-29-50	J-4	R.P.	R.P.
5-10-18	J	WGL	WGL	4-29-51	K-4	W.D.W.	W.D.W.
11-23-18	K	WGL	WGL	10-29-51	L-4	J.S.	J.S.
9-10-19	L	WGL	WGL	4-29-52	M-4	W.D.W.	W.D.W.
11-10-19	M	WGL	WGL	10-29-52	N-4	R.H.	R.H.
5-10-20	N	WGL	WGL	4-22-53	O-4	R.H.	R.H.
11-10-20	O	WGL	WGL	10-22-53	P-4	W.D.W.	W.D.W.
5-13-21	P	WGL	WGL	4-22-54	Q-4	W.D.W.	W.D.W.
11-10-21	Q	WGL	WGL	10-19-54	R-4	J.S.	J.S.
5-8-22	R	WGL	WGL	4-28-55	S-4	WGL	WGL
11-14-22	S	WGL	WGL	10-25-55	T-4	R.P.	R.P.
5-16-23	T	WGL	WGL				
11-16-23	U	WGL	WGL				
5-9-24	V	WGL	WGL				
11-9-24	W	WGL	WGL				
5-29-25	X	WGL	WGL				
11-10-25	Y	WGL	WGL				
5-10-26	Z	WGL	WGL				
11-8-26	A-1	WGL	WGL				
5-10-27	B-1	WGL	WGL				
11-8-27	C-1	WGL	WGL				
5-8-28	D-1	WGL	WGL				
11-6-28	E-1	WGL	WGL				
REASSIGNMENT							
4-27-43	R-2	WGL	WGL				
10-29-43	S-2	WGL	WGL				
4-29-44	T-2	WGL	WGL				
REASSIGNMENT							
11-11-44	X-3	WGL	WGL				
4-29-45	Y-3	WGL	WGL				
11-11-45	Z-3	WGL	WGL				
5-14-46	A-4	WGL	WGL				

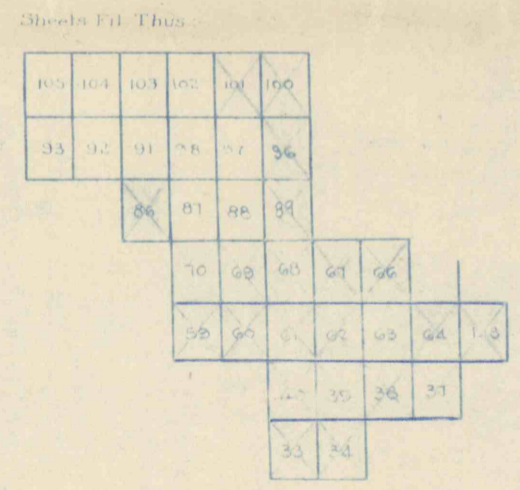

M O N O N G A H E L A R I V E R

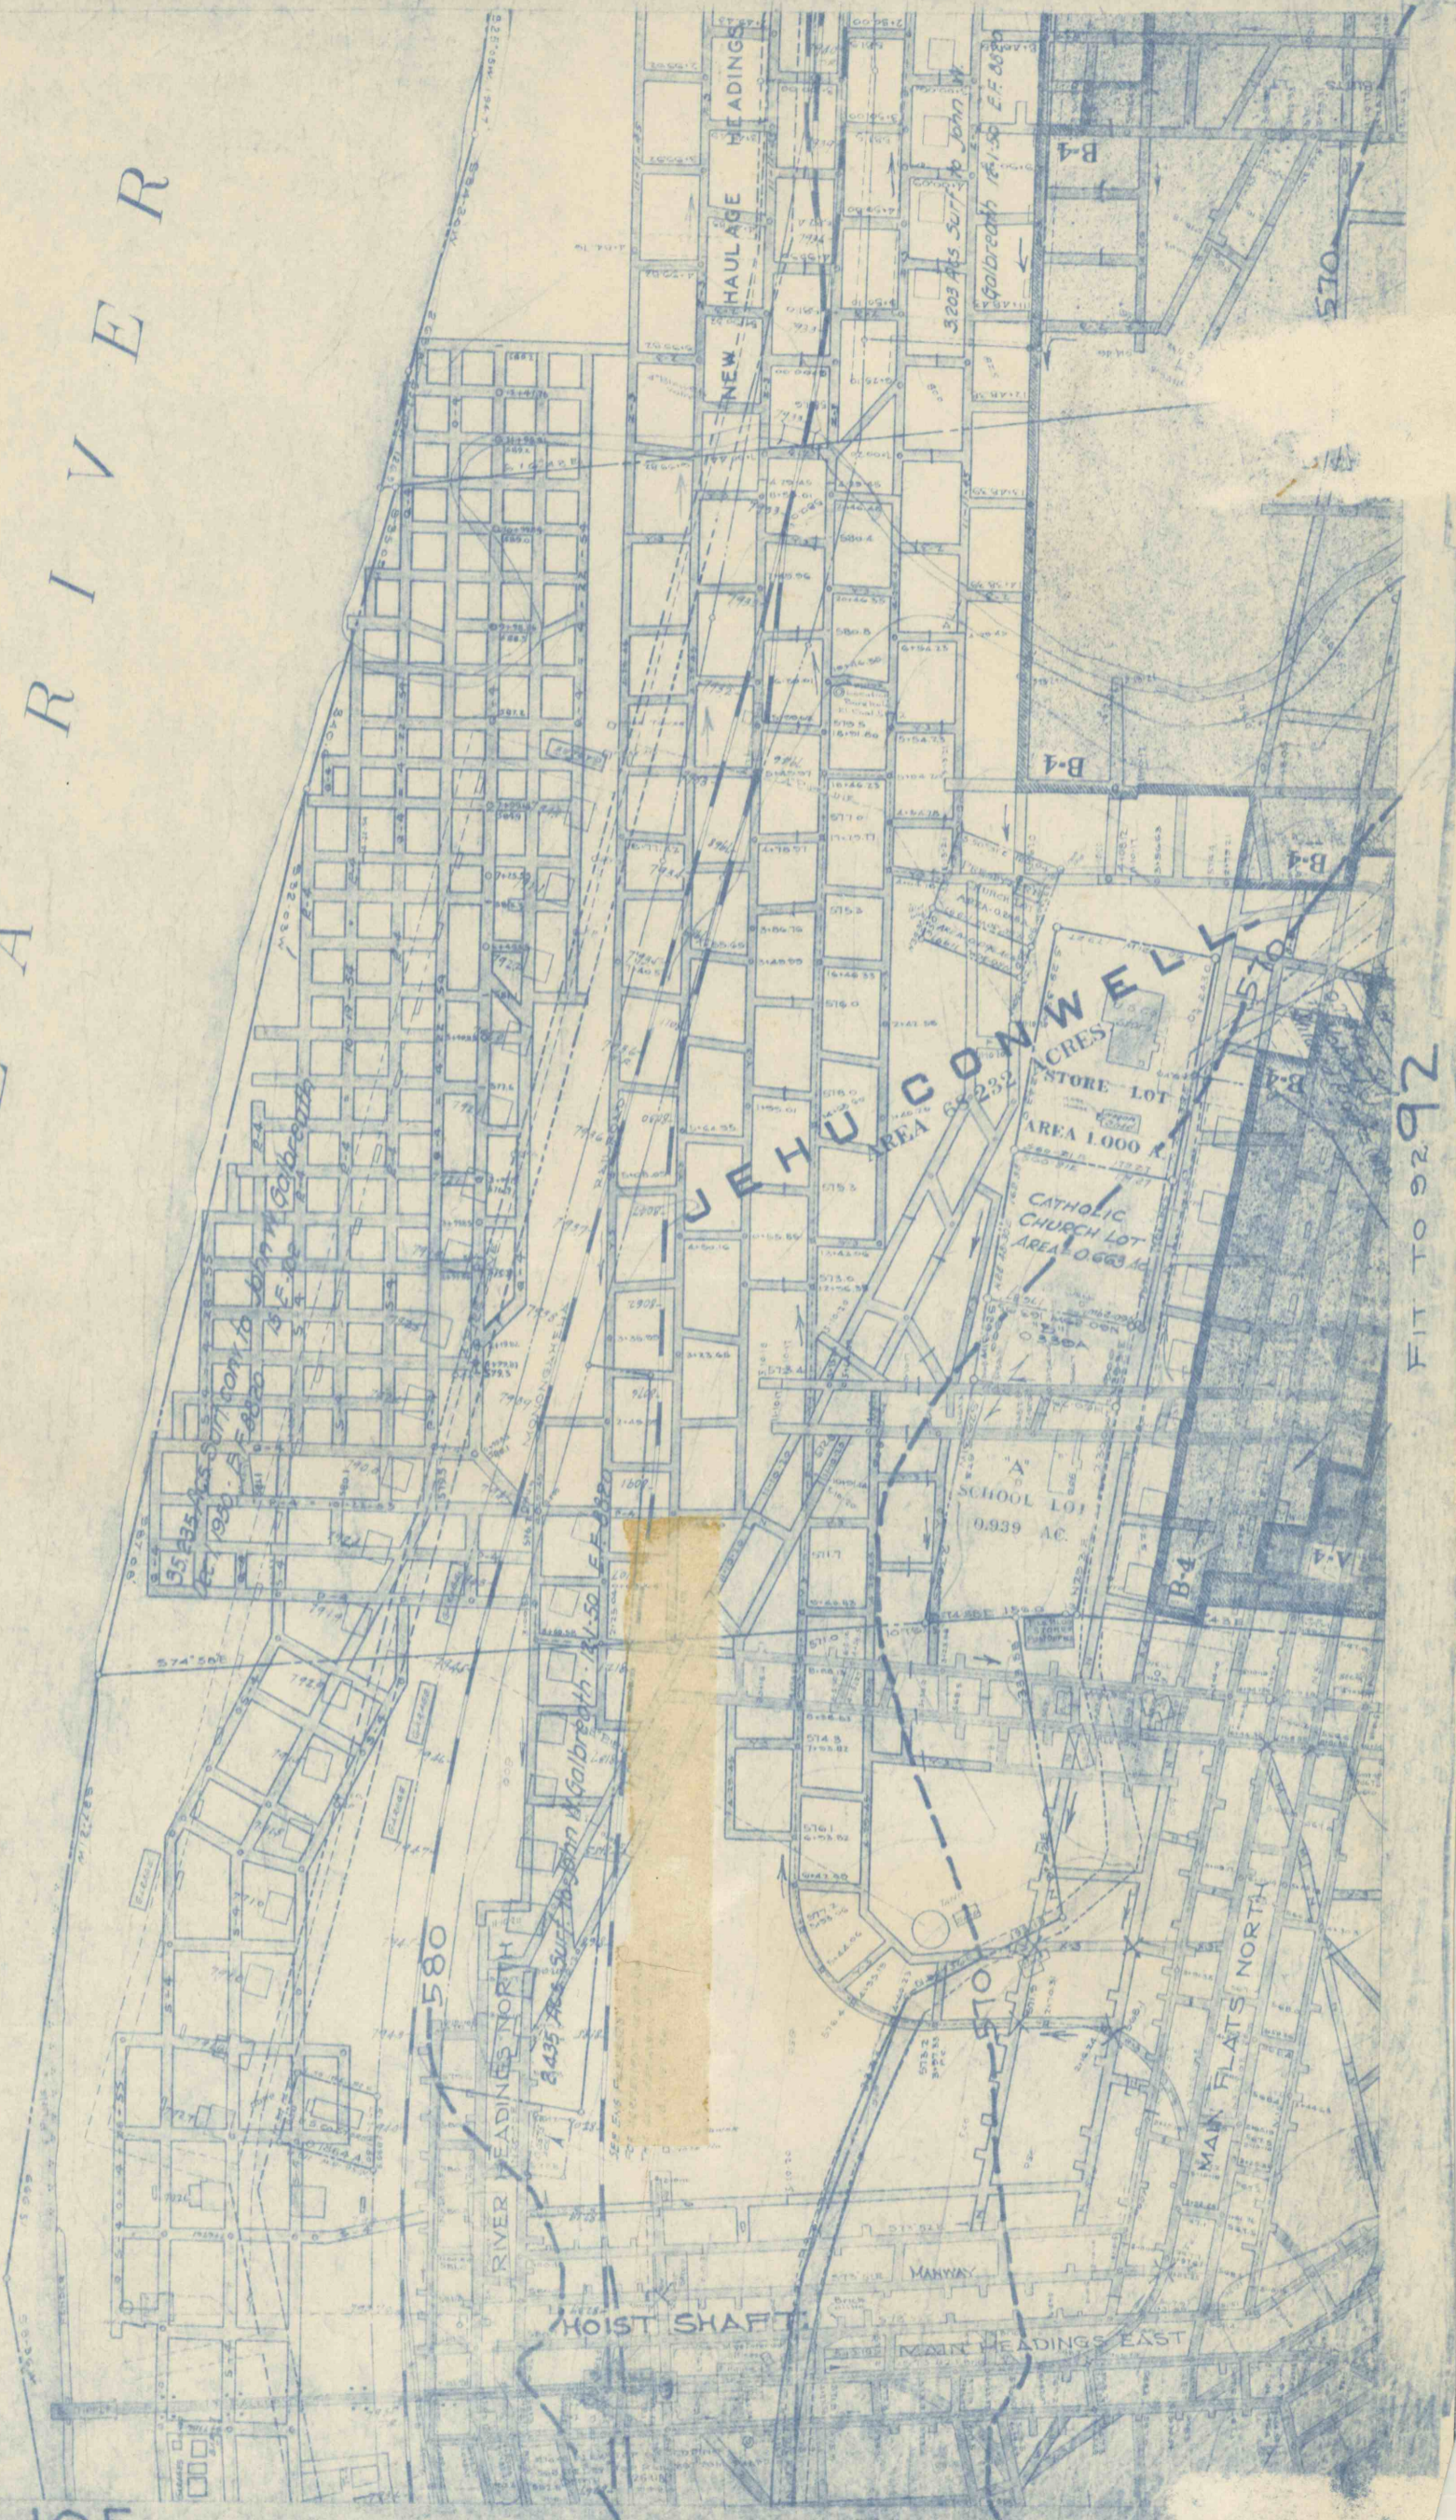

ELE. POOL FULL 760.4
ELE. HIGH WATER 763.1