


FILBERT PALMER

89

FIT TO 97

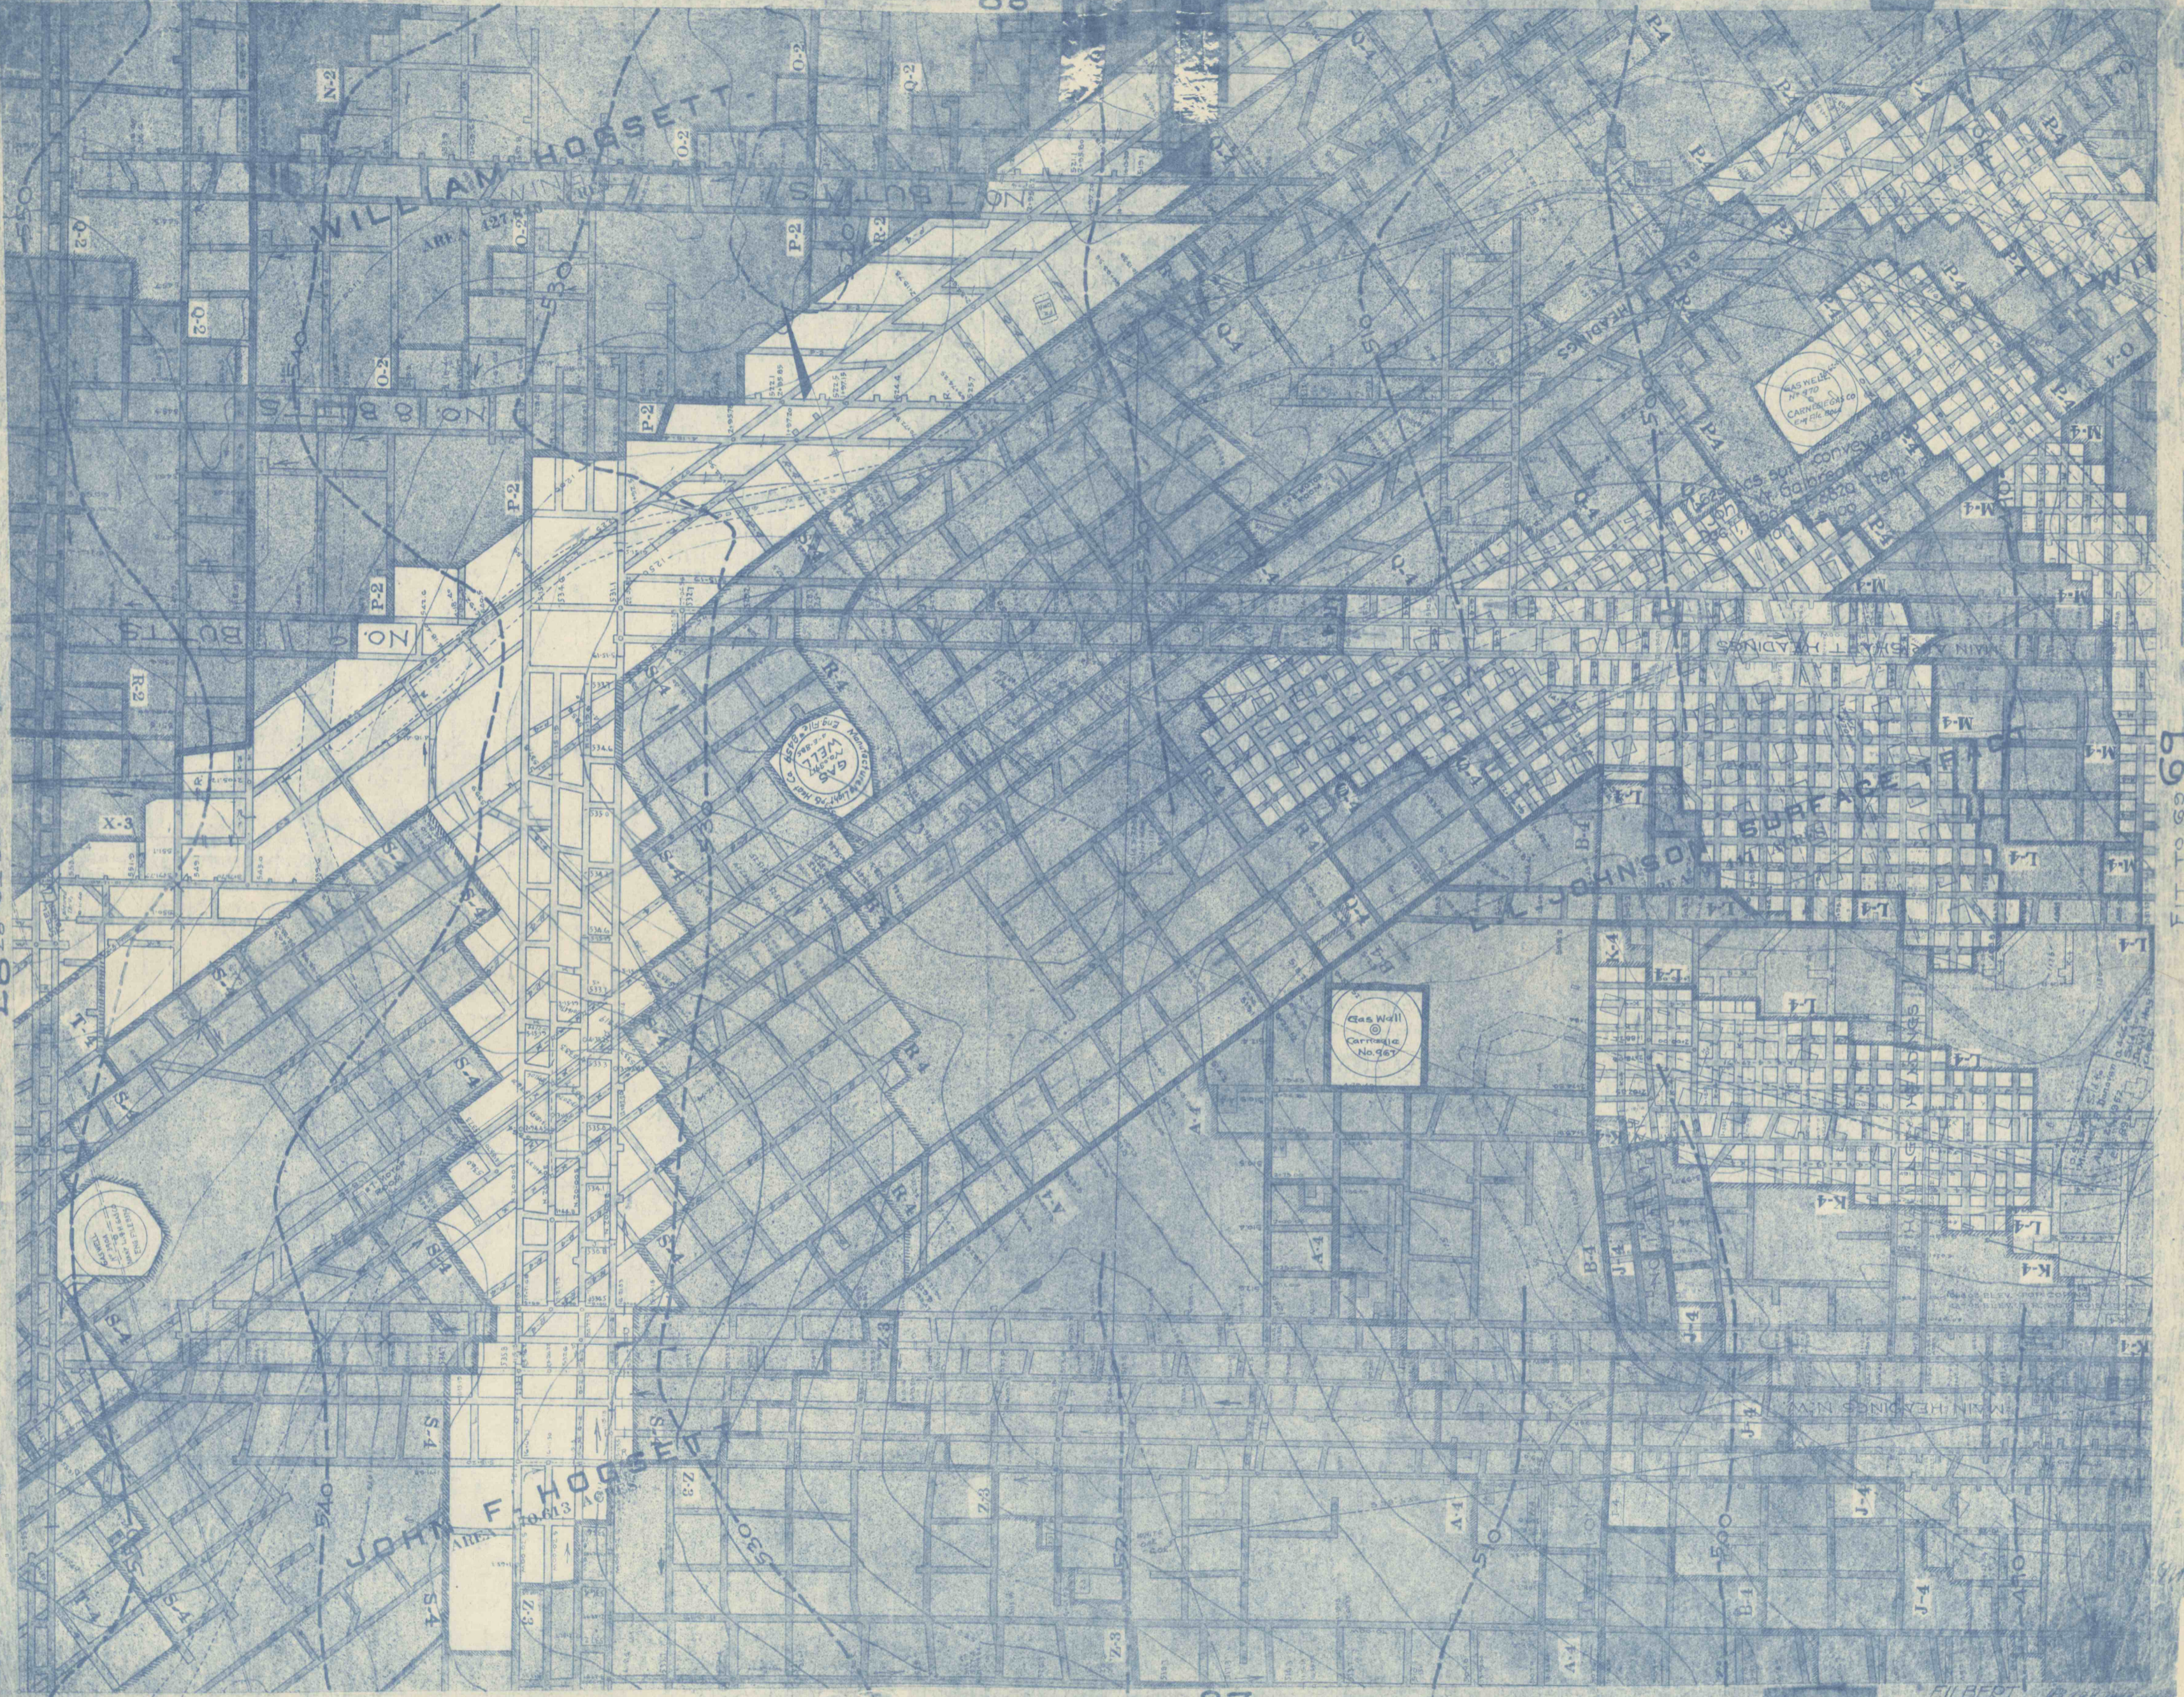

FIT TO 99

FIT TO 87

FILBERT PALMER