


88 88 of 111

PALMER 97  
FILBERT

98 FIT TO 98

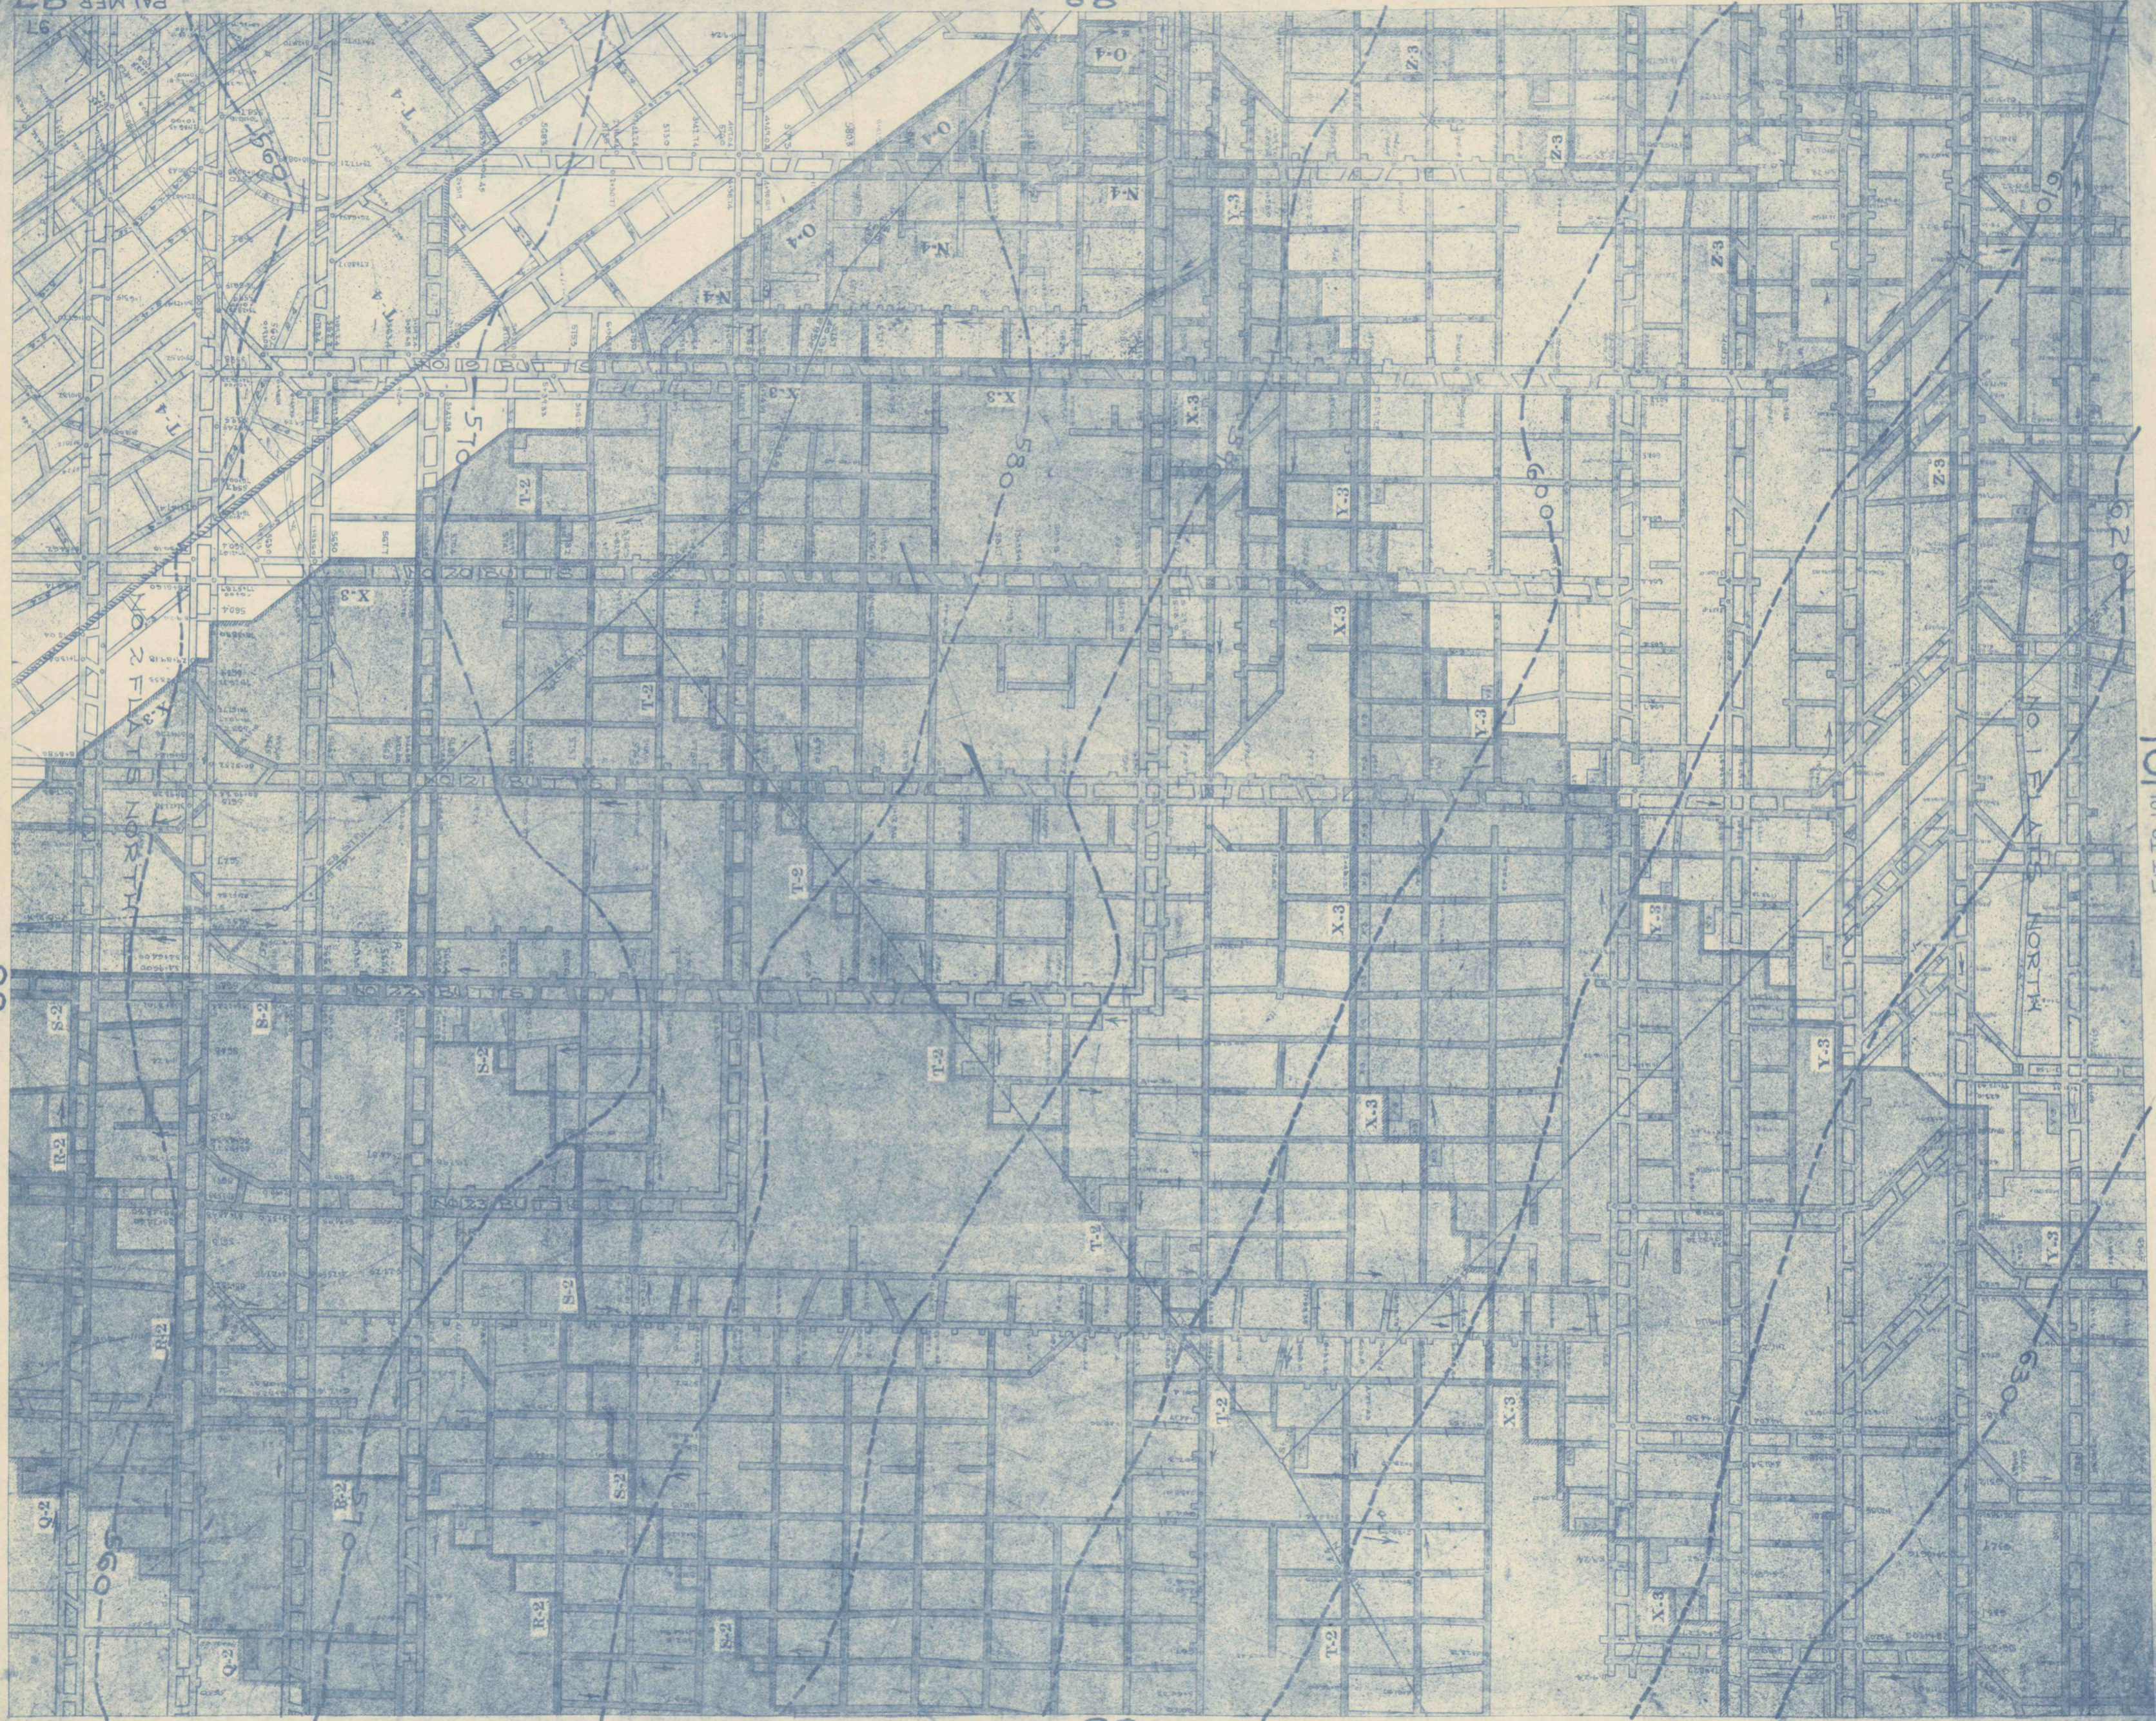

96 FIT TO 96

PALMER 98  
FILBERT

FIT TO 101 101