


FIT TO 102 102

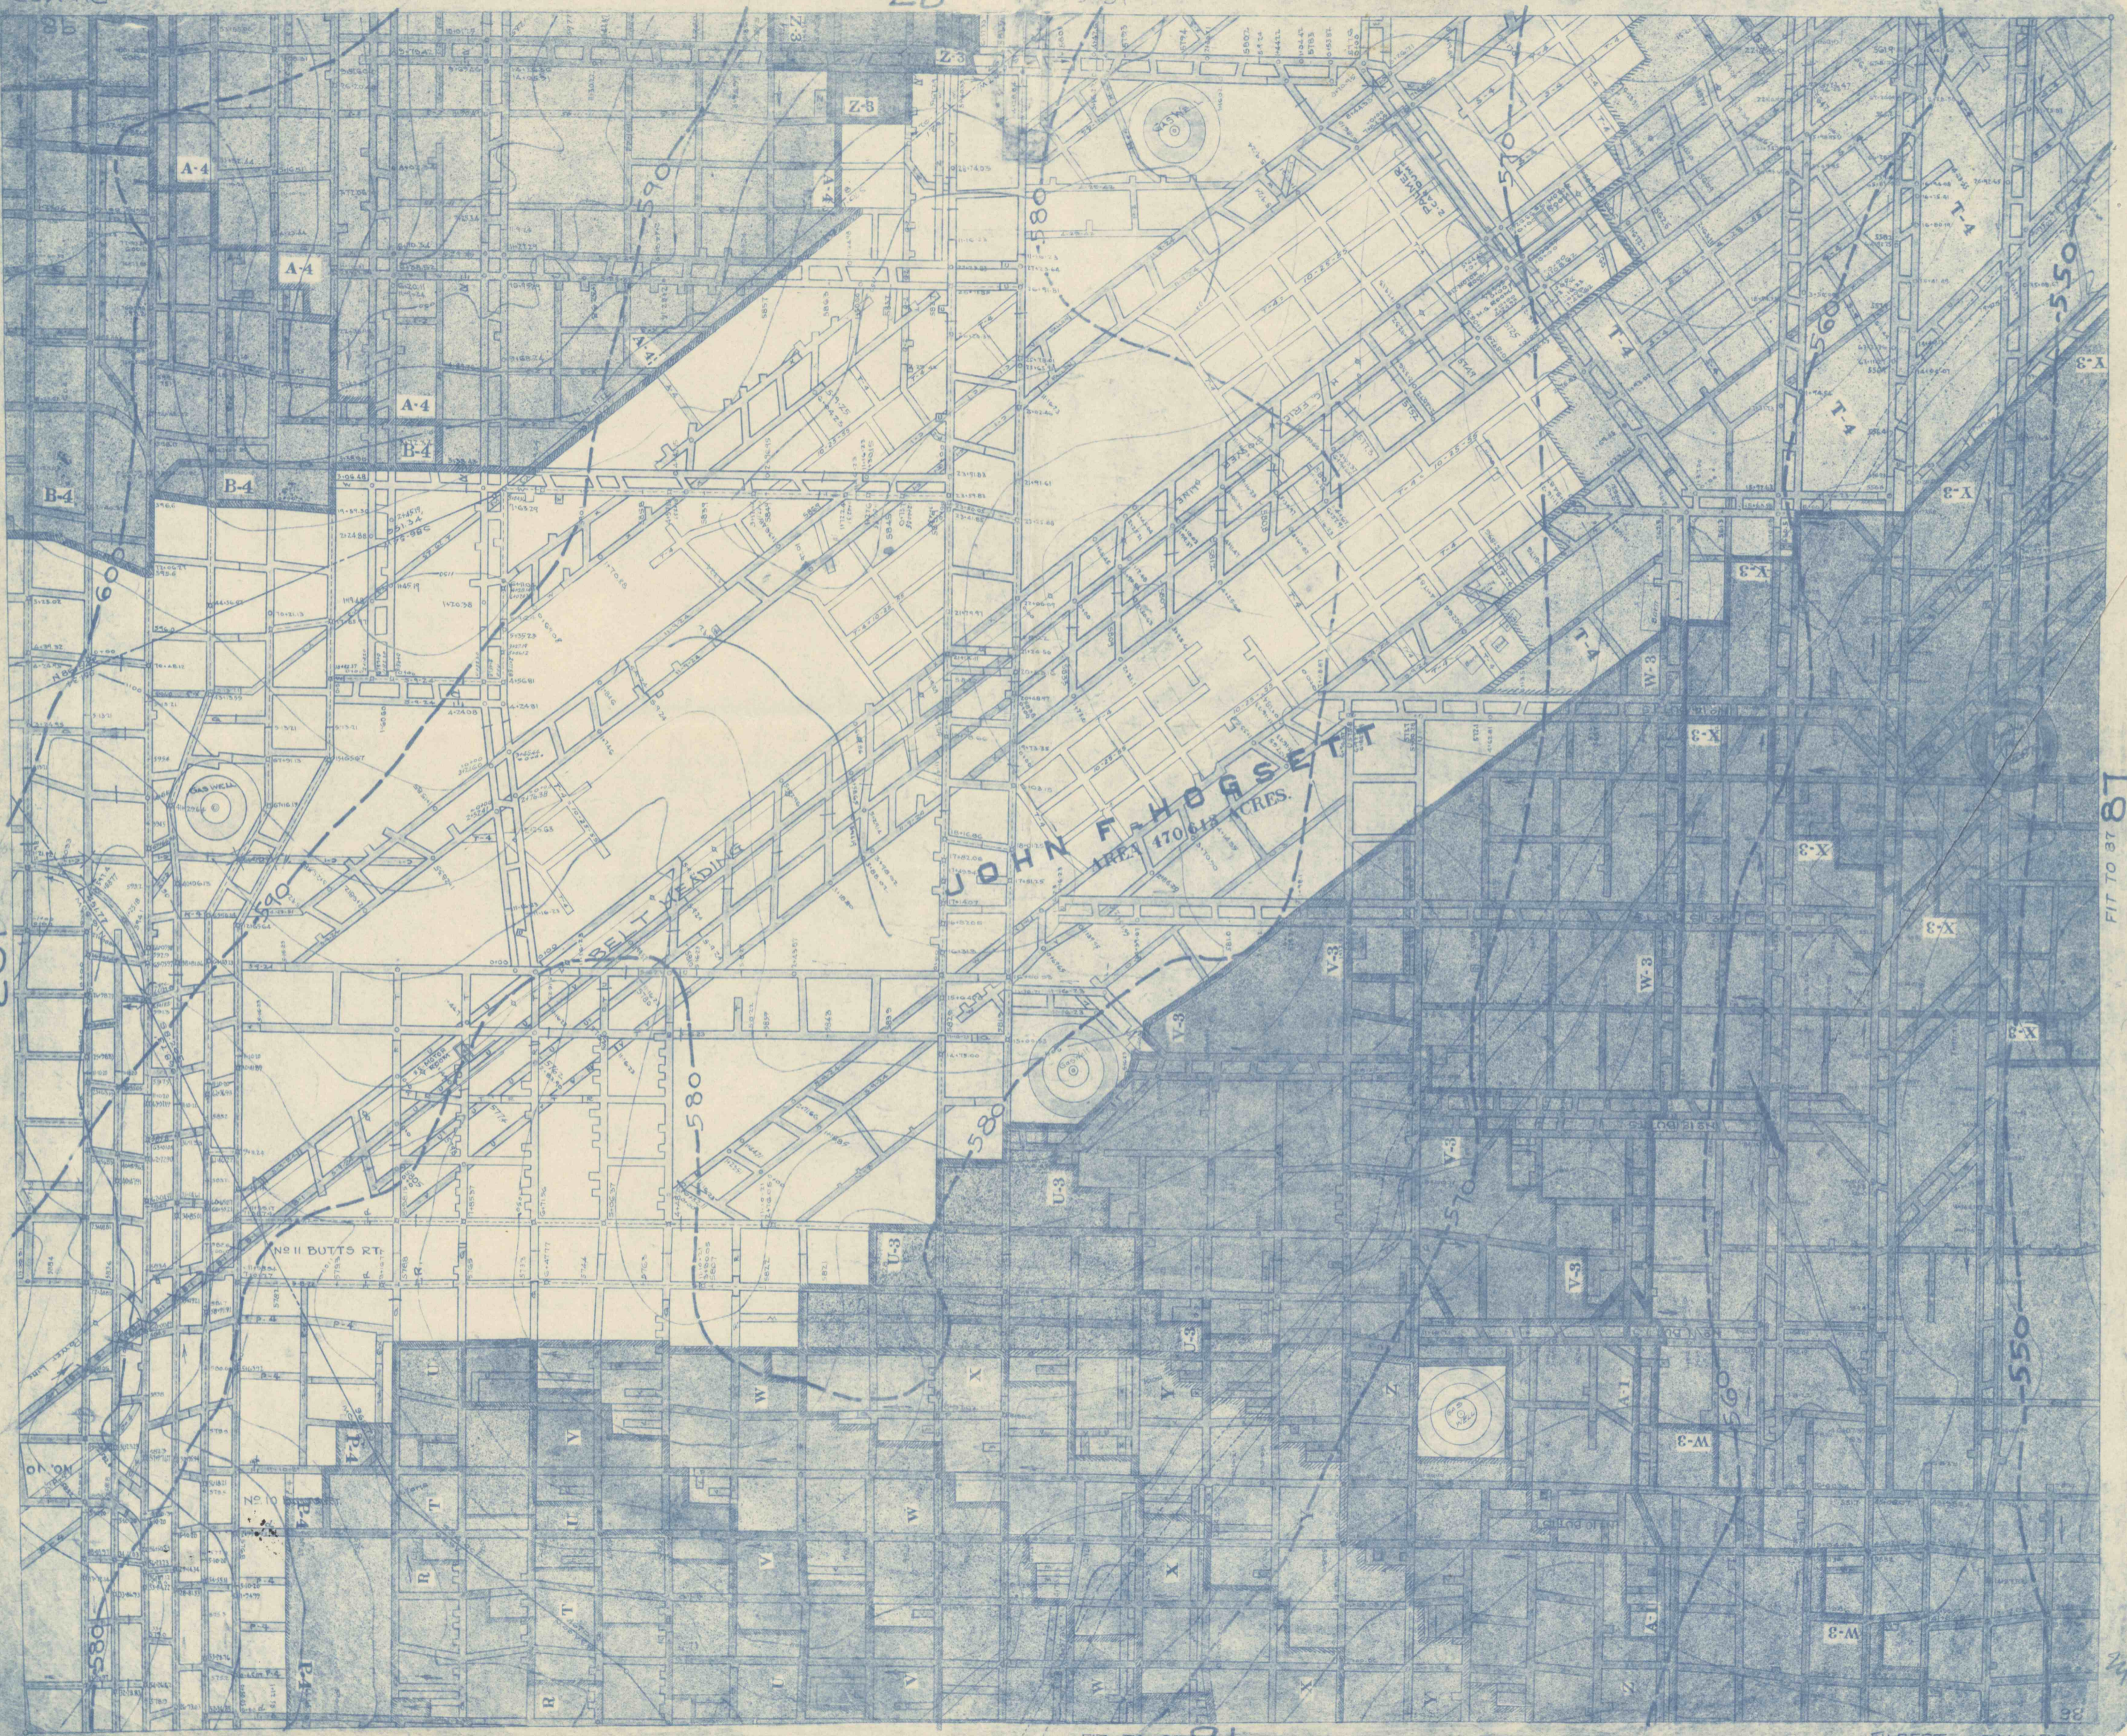

FIT TO 37 87