


41 FIT TO 174

PALMER  
FILBERT  
102

FIT TO 101  
101

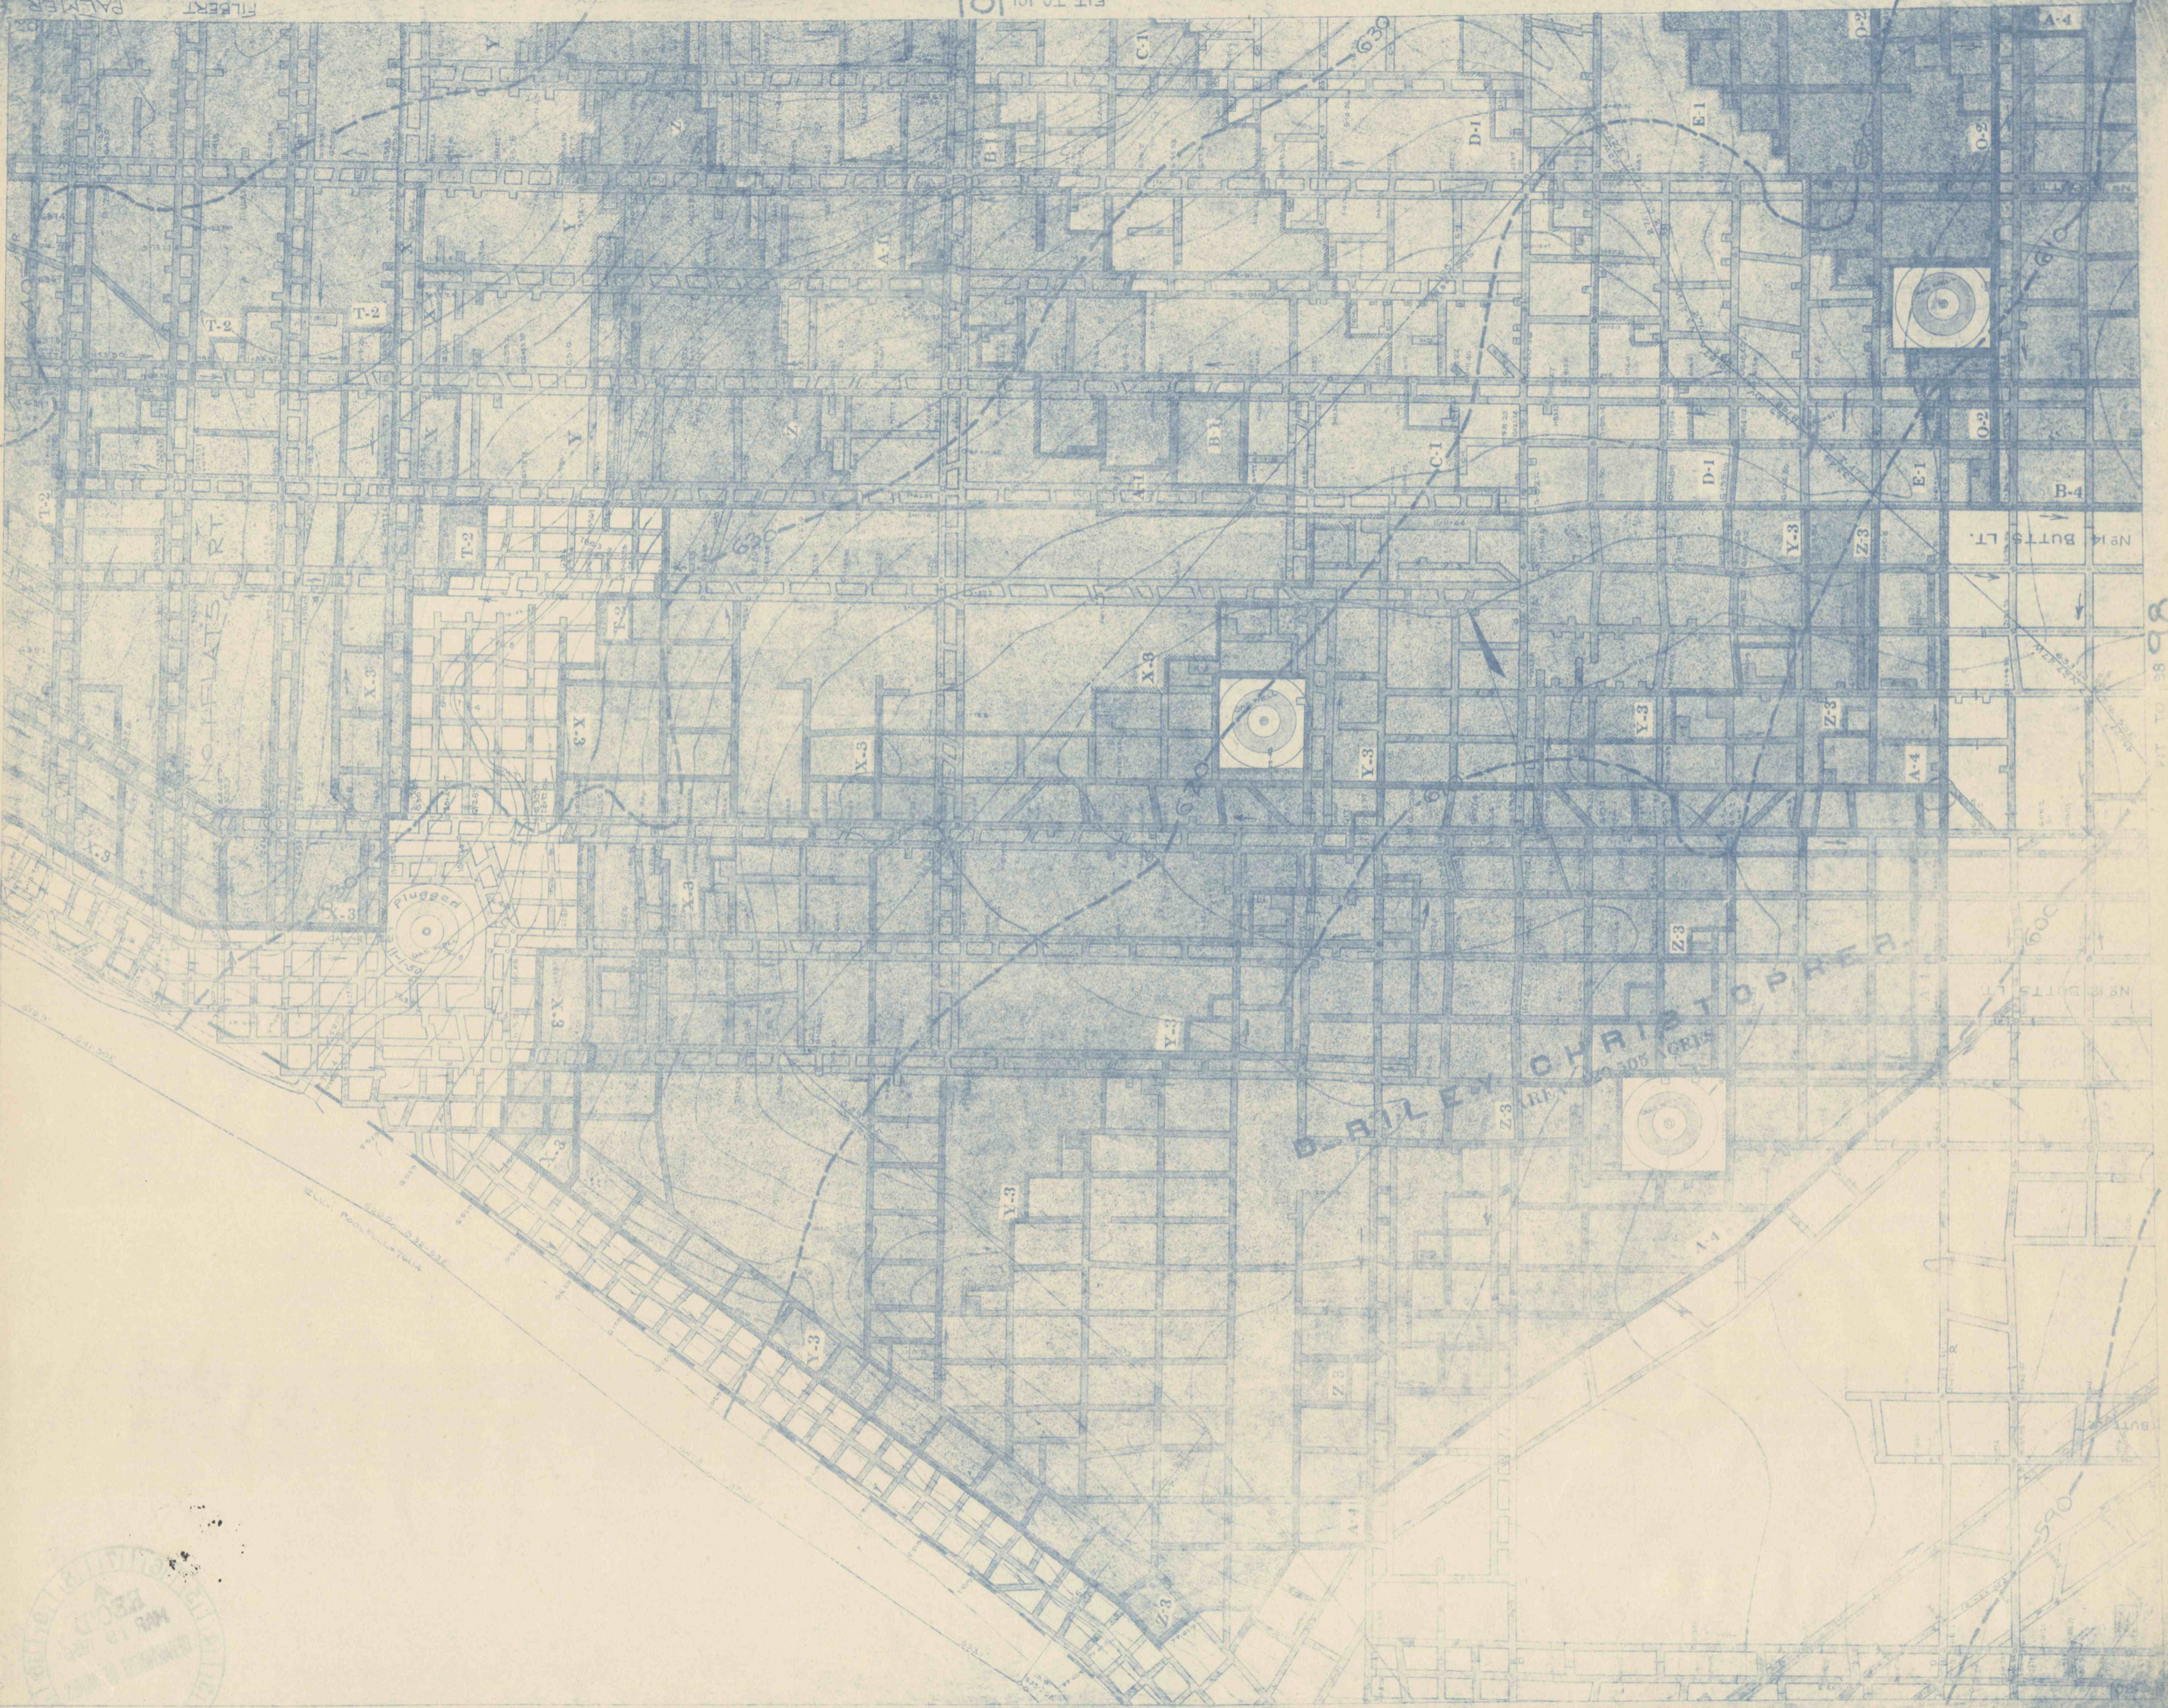

FIT TO 103 | 03

PALMER  
FILBERT | 02

FIT TO 38  
98