


CONSOLIDATION COAL COMPANY
DILWORTH MINE
PITTSBURGH SEAM OWNED OR CONTROLLED BY
CONSOLIDATION COAL COMPANY
GREEN COUNTY, PA.

DATE: 11-20-88 SURVEY DATE: 11-20-88

LEGEND:

- UNMINED MINING 11-88 TO 11-88
- MINING FROM 11-88 TO 11-88
- PROTECTED STRUCTURES CURRENT SUBMISSION
- SUPPORT AREA
- MINING COMPLETED AREA
- LAND BUILT AFTER DATE OF 11-88
- PROTECTED STRUCTURES PREVIOUS SUBMISSION
- PARTIAL SECONDARY MINING COMPLETED
- MINING AREA TO BE MINED IN ACCORDANCE WITH THE APPROVED WELL FILLING PERMIT, NUMBERS SHOWN ON EACH WELL.
- EXCHANGE LINE
- SUSPENSION CONTROL PLAN LINE

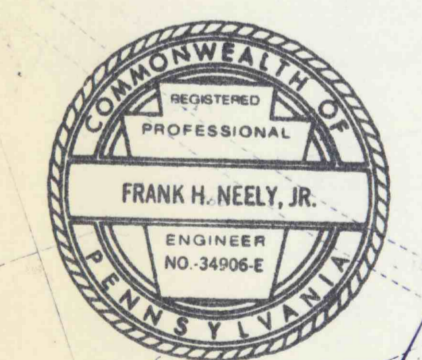

Frank H. Neely, Jr.

RECEIVED
JUL 29 1988
Dept. of Environmental Resources
McMurray District Office

LEWIS YOUNG - 29
AREA 66.836 ACRES

PARCEL "A"
4.424 ACRES

PARCEL "B"
11.027 ACRES

GEORGE F. LUSE-248C
AREA 47.439 ACRES

Strip Conveyed To Crucible Fuel Co. By Deed Dated Dec 22, 1942. Eng. File 7855