

W. J. RAINEY CO.
MT. BRADDOCK MINE

BARRIER

COAL LINE

BARRIER

COAL LINE

DUNBAR FURNACE CO.
FERGUSON MINE

BARRIER

COAL LINE

DUNBAR FURNACE CO.
FERGUSON MINE

COAL LINE

United States Steel Corp.
Surface

STRIPPING

STRIPPING


STRIPPING

STRIPPING

STRIPPING

UNITED STATES STEEL CORPORATION
36-02810-0
MT. BRADDOCK MINE


FAYETTE COUNTY, PENNSYLVANIA
DUNBAR TWP. NORTH UNION TWP.

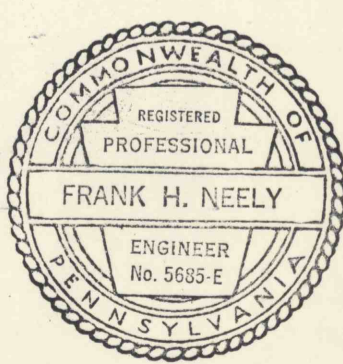

Frank H. Neely 5-27-79

SCALE
1"=200'

1970

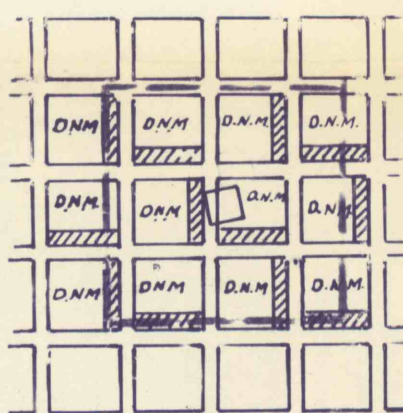

TYPICAL PLAN OF 50% MINING
FOR DWELLING SUPPORT

SURVEY DATE 6-30-79

SHOWN IN GREEN — PROJECTION OF MINING TO BE PERFORMED FROM 6-30-79 TO 12-31-79