





UNITED STATES STEEL CORPORATION
 36-02810-0
MT. BRADDOCK MINE

FAYETTE COUNTY, PENNSYLVANIA
 DUNBAR TWP. NORTH UNION TWP.

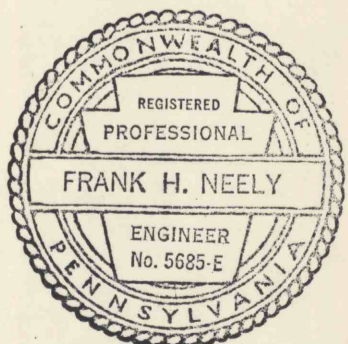

Frank H. Neely

SCALE
 1" = 200'

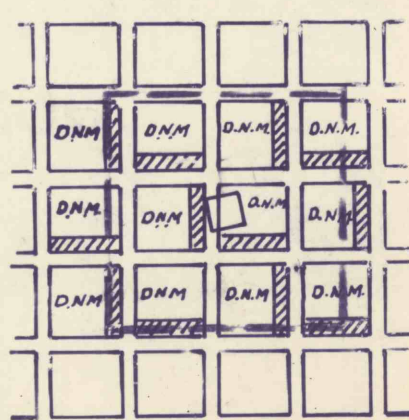

TYPICAL PLAN OF 50% MINING
 FOR DWELLING SUPPORT

1970

SURVEY DATE 6-30-78

SHOWN IN GREEN — PROJECTION OF MINING TO BE PERFORMED FROM 6-30-78 TO 12-31-78

MT. BRADDOCK MINE
 MINE SUB TRAC.
 1" = 200'
 Scale

MT. BRADDOCK MINE
 1" = 200'