


UNITED STATES STEEL CORPORATION
36-02810-0
MT. BRADDOCK MINE

FAYETTE COUNTY, PENNSYLVANIA
DUNBAR TWP. NORTH UNION TWP.

SCALE
1"=200'

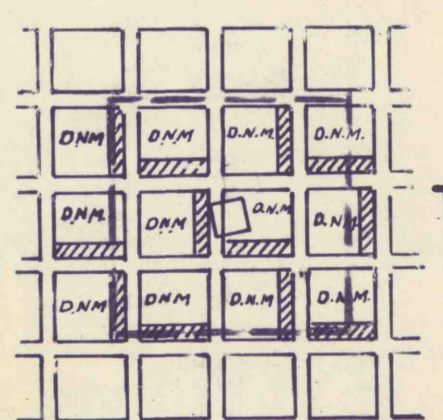

TYPICAL PLAN OF 50% MINING
FOR DWELLING SUPPORT

1970

SURVEY DATE 6-30-77

SHOWN IN GREEN — PROJECTION OF MINING TO BE PERFORMED FROM 6-30-77 TO 12-31-77



Frank H. Neely 6-26-77