



UNITED STATES STEEL CORPORATION
36-02810-0
MT. BRADDOCK MINE

FAYETTE COUNTY, PENNSYLVANIA
DUNBAR TWP. NORTH UNION TWP.

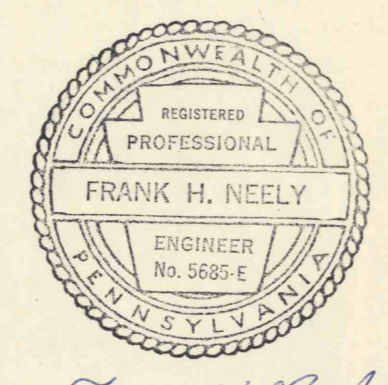

Frank H. Neely 1-24-78

SCALE
1"=200'

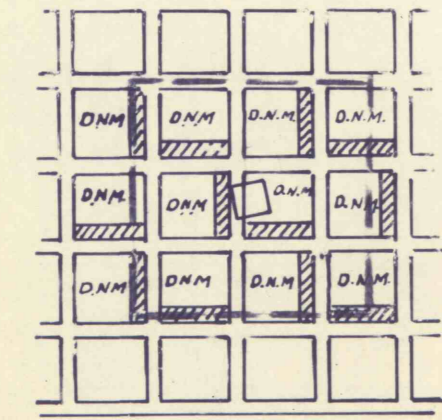

TYPICAL PLAN OF 50% MINING
FOR DWELLING SUPPORT

1970

SURVEY DATE 12-31-77

SHOWN IN GREEN — PROJECTION OF MINING TO BE PERFORMED FROM 12-31-77 TO 6-30-78