


UNITED STATES STEEL CORPORATION
36-02810-0

MT. BRADDOCK MINE

FAYETTE COUNTY, PENNSYLVANIA
DUNBAR TWP. NORTH UNION TWP.

SCALE 1"=200'

1970

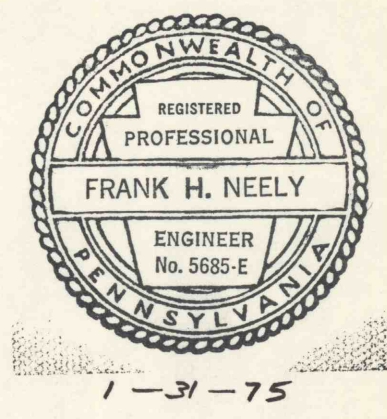

1-31-75