


UNITED STATES STEEL CORPORATION
36-02810-0

MT. BRADDOCK MINE

FAYETTE COUNTY, PENNSYLVANIA
DUNBAR TWP. NORTH UNION TWP.

SCALE
1" = 200'

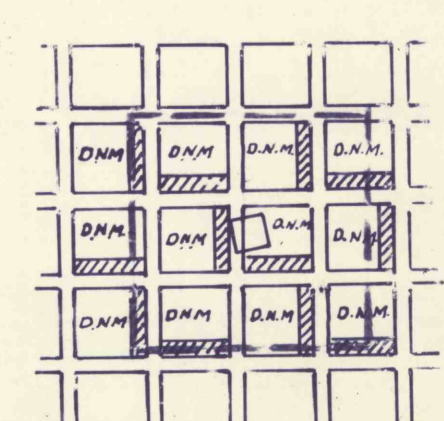

TYPICAL PLAN OF 50% MINING
FOR DWELLING SUPPORT

1970

SURVEY DATE 12-31-78

SHOWN IN GREEN — PROJECTION OF MINING TO BE PERFORMED FROM 12-31-78 TO 6-30-79



Frank H. Neely 2-15-79