



UNITED STATES STEEL CORPORATION
 36-02810-0
MT. BRADDOCK MINE
 FAYETTE COUNTY, PENNSYLVANIA
 DUNBAR TWP. NORTH UNION TWP.

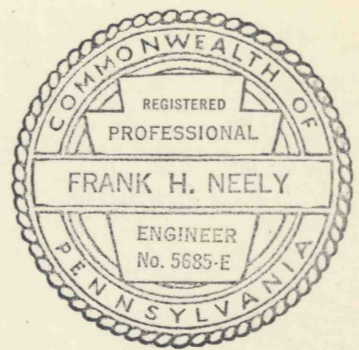

Frank H. Neely 2-4-81

SCALE
1"=200'

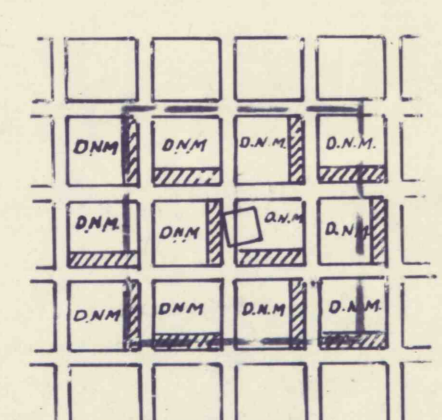

TYPICAL PLAN OF 50% MINING
FOR DWELLING SUPPORT

1970

SURVEY DATE 12-31-80

SHOWN IN GREEN — PROJECTION OF MINING TO BE PERFORMED FROM 12-31-80 TO 6-30-81