




MATCH TO 19

PLUMCEEK & SOUTH BEND TOWNSHIPS,  
 ARMSTRONG COUNTY

**EMILIE No. 1 & 2 MINE**  
 (UPPER FREEPORT COAL SEAM)

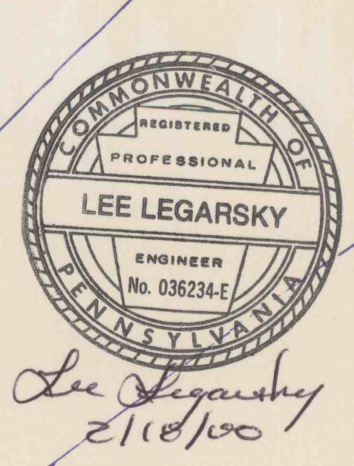

POSTING DATE 12-1-1999  
 FINAL MINE MAP

