



MATCH TO 17A

MATCH TO 18

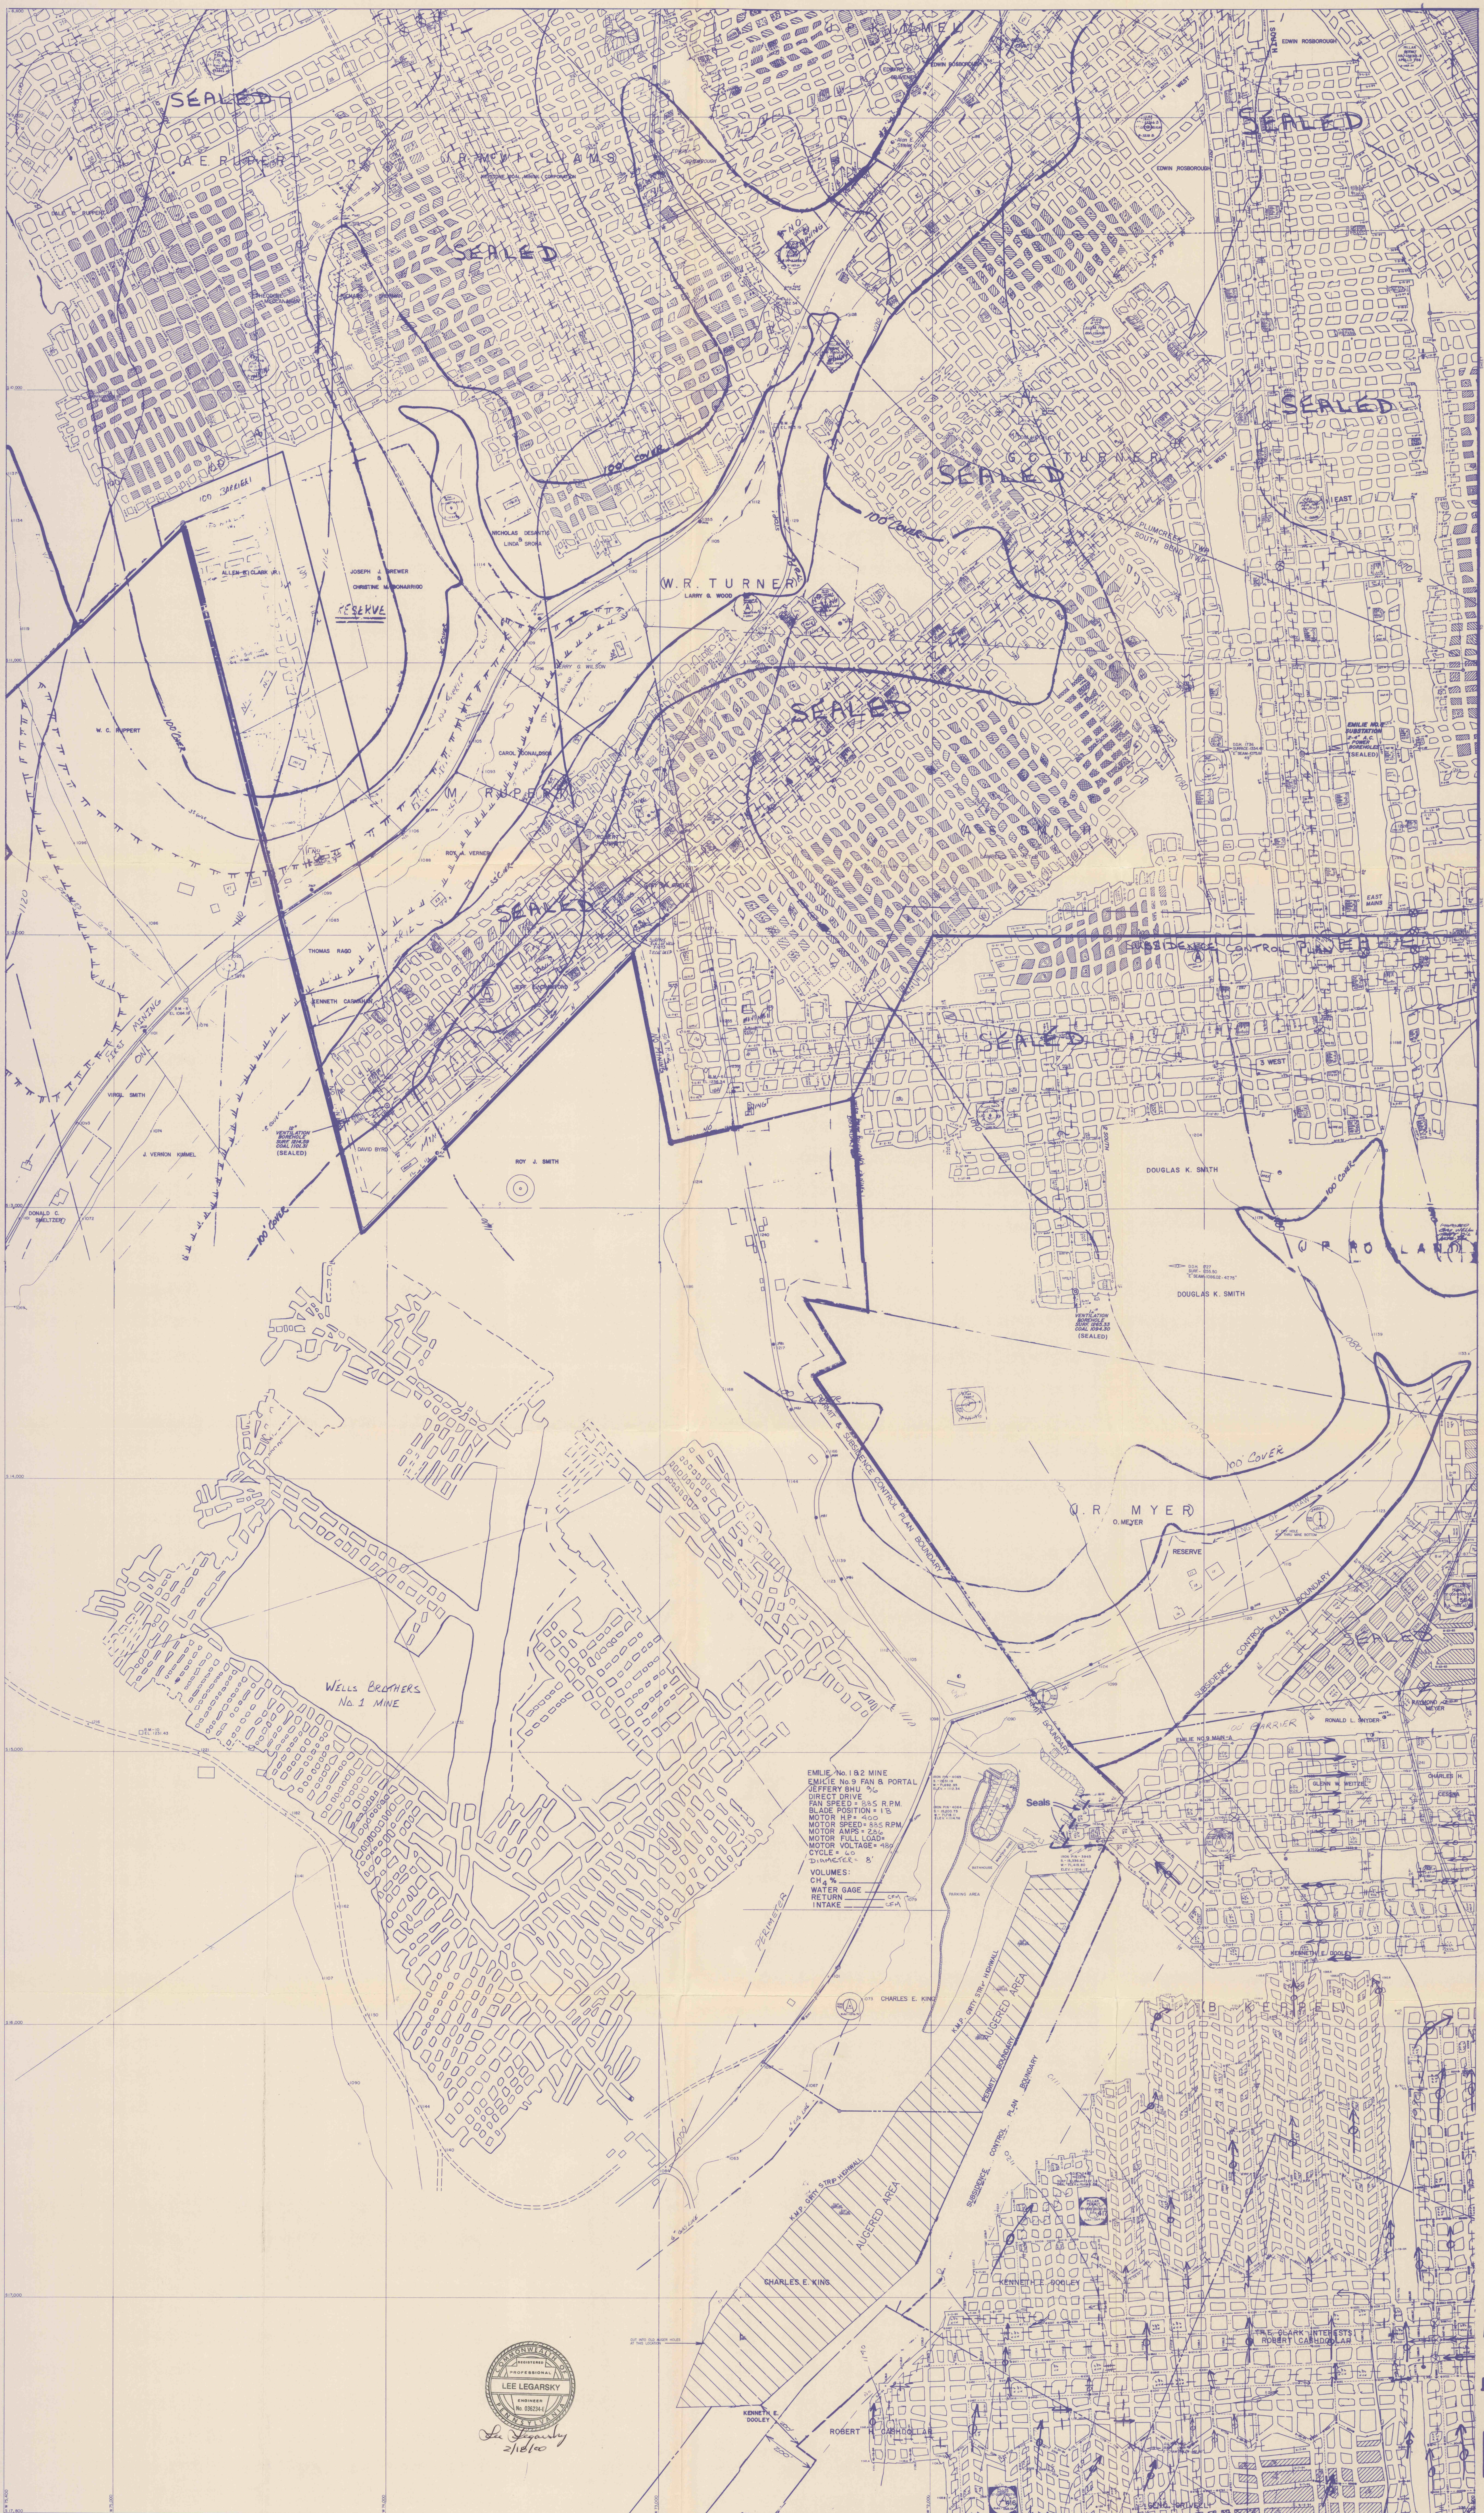

EMILIE No. 1 & 2 MINE
 EMILIE No. 9 FAN & PORTAL
 JEFFERY SHU
 DIRECT DRIVE
 FAN SPEED = 585 R.P.M.
 BLADE POSITION = 15
 MOTOR H.P. = 400
 MOTOR SPEED = 595 R.P.M.
 MOTOR AMP. = 225
 MOTOR VOLTAGE = 480
 CYCLE = 60
 DIMENSIONS = 8'

VOLUMES:
 CH. 2
 WATER GAGE
 RETURN
 INTAKE

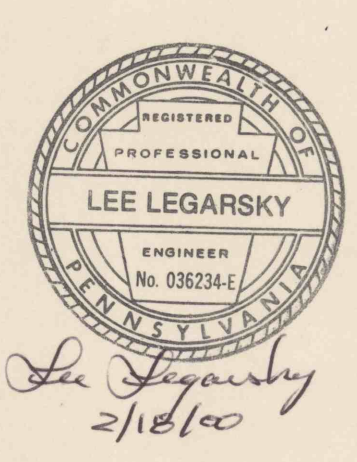

POSTING DATE 12-1-1979
FINAL MINE MAP

